

MARION COUNTY SURVEYOR'S OFFICE


SECTION CORNER RECORD

DEBRA S. JENKINS
MARION COUNTY SURVEYOR

SEC. 21 TWN. 14_N RNG. 3_E


BRYAN F. CATLIN, PS
TECHNICAL SUPERVISOR

Date: 10/29/2013
Party Chief: Wilcoxon
Crew: Gowin
Type of Marker: MAG Nail
Method of Establishment: County: 1/8/2000
IN S.P.C. E Zone, NAD 83 (1986)
Name: 14032117
N: 487 863. 575 (m)
E: 53 303. 589 (m)

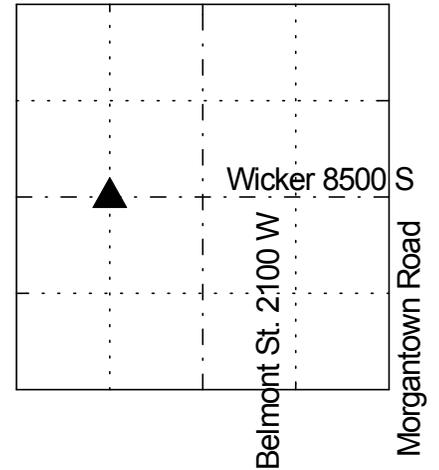

THIS CORNER POSITION REPRESENTS A "TITLE" CORNER AND MAY NOT NECESSARILY REPRESENT THE POSITION BASED ON RECORD CORNERS.

Southern Dunes Golf Course

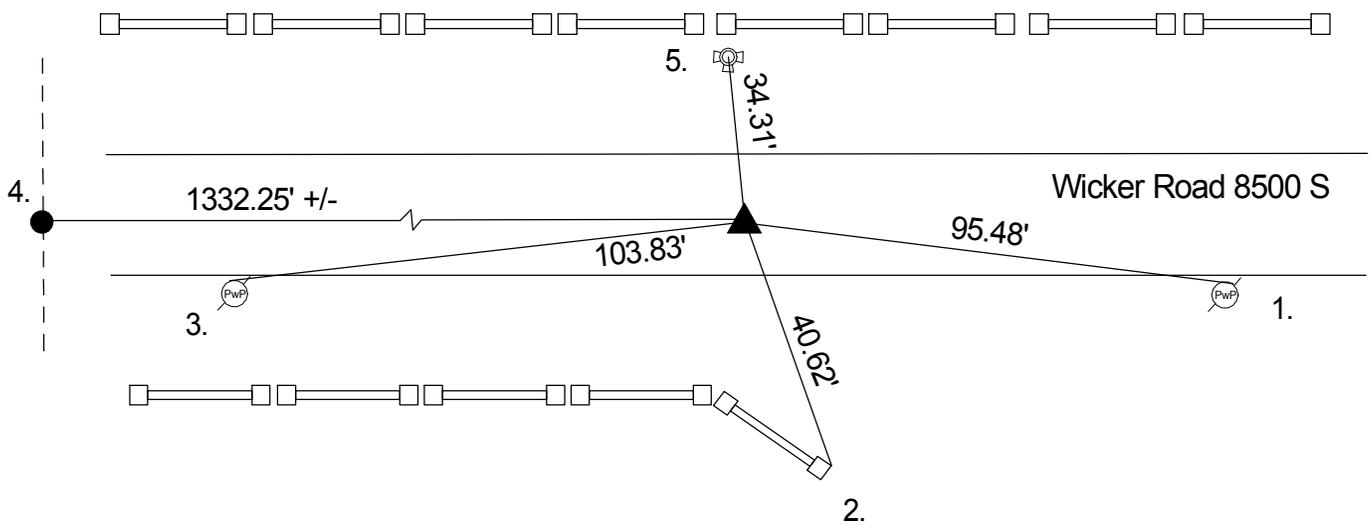

John V. Coyner 1/18, 19, 22/1900 set Stone with witnesses: Stone North 15 feet, Stone South 23 feet (Perry Twp. Legal Survey Book pg. 64). R. Miller 12/6/1976 called 3/4" I. Pipe. Green 2/4/1986 called RR Spike at surface and noted 3/4" Iron Pipe was dug up in 1985 while traversing section. Wilcoxon 1/17/1995 found RR Spike. Kiste 1/8/2000 found RR Spike. Whiteside 5/23/2005 found MAG Nail at surface. Wilcoxon 10/29/2013 found MAG Nail at surface.

REF	DISTANCE	DESCRIPTION
1.	95.48'	Road Nail N PwP #7-810 6" up
2.	40.62'	E Corner of Plastic Fence Post
3.	103.83'	MAG Nail w/washer N PwP #8-810 8" up
4.	1332.25' +/-	Due W to Section Line 3400 W
5.	34.31'	Top Nut of Fire Hydrant