

MARION COUNTY SURVEYOR'S OFFICE

SECTION CORNER RECORD

DEBRA S. JENKINS
MARION COUNTY SURVEYOR

SEC. 6 TWN. 14 N RNG. 4 E



BRYAN F. CATLIN, PS
TECHNICAL SUPERVISOR

Date: 9/22/2015
Party Chief: Wilcoxon
Crew: Wilburn
Type of Marker: Harrison
Method of Establishment: County: 4/11/1996
IN S.P.C. E Zone, NAD 83 (1986)
Name: 14040601; 14030103; 15043107; 15033609
N: 493 592. 311 (m)
E: 59 468. 591(m)

SEC. 1 TWN. 14 N RNG. 3 E

SEC. 31 TWN. 15 N RNG. 4 E

SEC. 36 TWN. 15 N RNG. 3 E

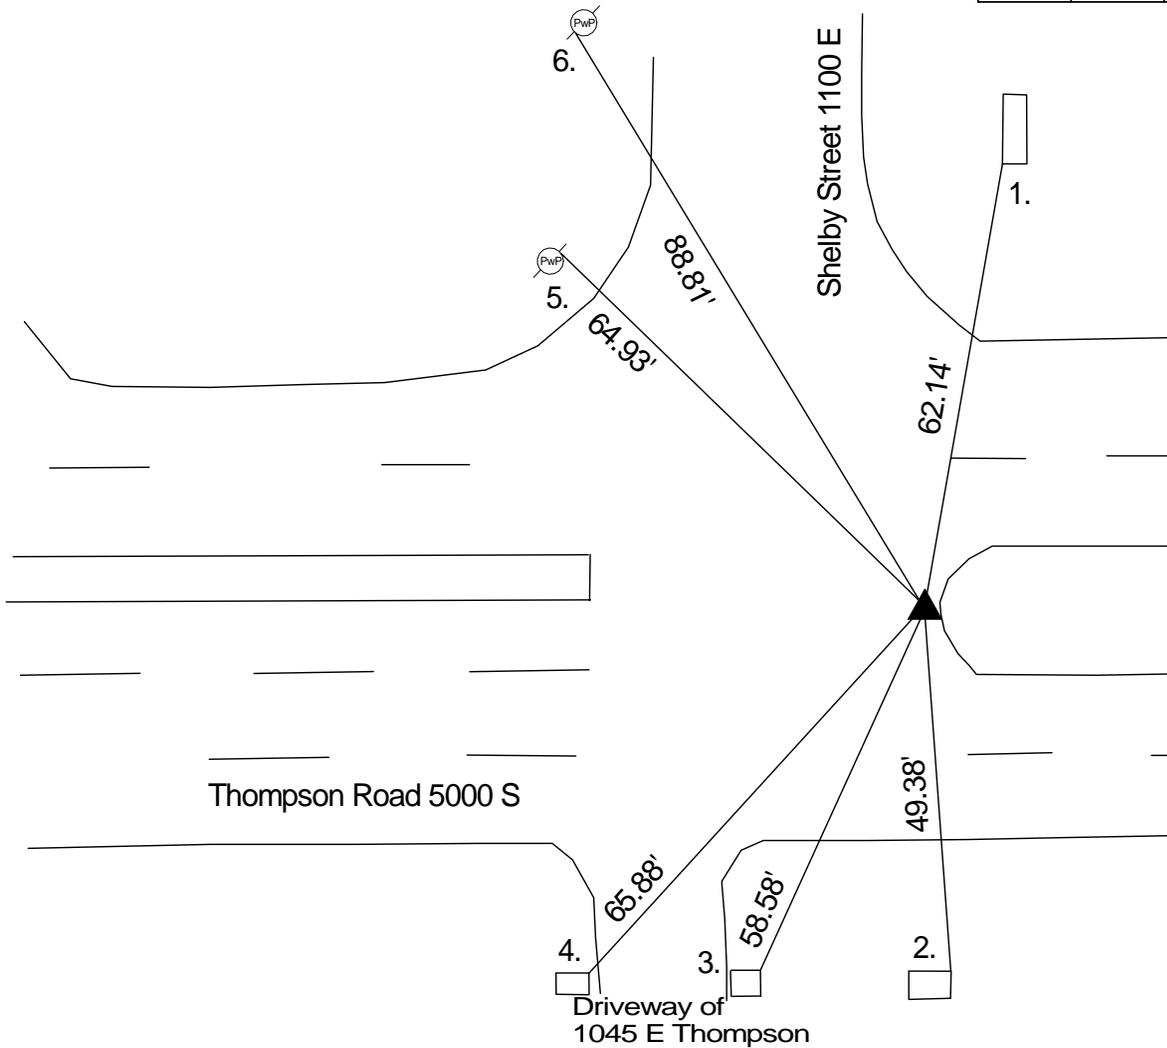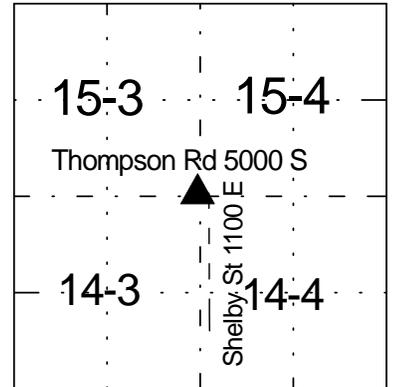

Original post set in 1819 by John McDonald with witnesses: 16" Beech N 81°W 25 links, 23" Beech S 29°E 35 links (Marion County Atlas pg. 5). P. Hosbrook 4/16-17/1849 noted 'Large rock and one witness' (Perry Twp. Legal Survey Book pg. 5). O.W. Voorhis 3/21-22/1861 found Rock by Kinder and noted distance to it (Perry Twp. Legal Survey Book pg. 38). H.B. Fatout 1/24/1881 noted distances to corner (Perry Twp. Legal Survey Book pg. 71). Hervey B. Fatout 9/11/1884 noted distances to corner (Perry Twp. Legal Survey Book pg. 38). Chas. A. Brown 3/1893 noted distances to corner (Perry Twp. Legal Survey Book pg. 49). N.C. Thompson 12/9/1946 called RR Spike. Monroe 3/29/1961 called RR Spike. Howe 6/2/1971 called RR Spike 6" down. McLand 6/19/1973 found PK Nail. Hylden 10/4/1974 called Brass Plug. Hylden 1/31/1978 called Brass Plug. Gries/Greene 12/2/1987 called Brass Plug. Wilcoxon 4/11/1996 called bent PK Nail in concrete street. Wilcoxon 4/12/1996 called bent PK Nail in concrete street. Whiteside 3/10/2001 called Copperweld with punch set by MCSO. Wilcoxon 3/17/2001 called Copperweld. Whiteside 3/18/2001 called bent PK Nail in concrete street. Wilcoxon 4/29/2001 called Brass Plug. Wilcoxon 6/27/2006 called Brass Plug. Kiste 10/4/2006 called Copperweld with punch hole. Wilcoxon 8/13/2007 found Brass Plug. Wilcoxon 9/5/2013 found Copperweld. Wilcoxon 8/28/2015 excavated, no points found, set Harrison per coordinates. Wilcoxon 9/22/2015 found Harrison.

REF	DISTANCE	DESCRIPTION
1.	62.14'	Top Perry Govt. Sign SW Corner
2.	49.38'	NE Corner Stone Pillar
3.	58.58'	NE Corner Stone Pillar
4.	65.88'	NE Corner Stone Pillar
5.	64.93'	MAG Nail NE PWP no # 12" up
6.	88.81'	PK Nail SW PwP# 17-697-A 50" up