

MARION COUNTY SURVEYOR'S OFFICE

SECTION CORNER RECORD

DEBRA S. JENKINS
MARION COUNTY SURVEYOR



SEC. 9 TWN. 14_N RNG. 4_E

BRYAN F. CATLIN, PS
TECHNICAL SUPERVISOR

Date: 6/23/2015
Party Chief: Wilcoxon
Crew: Greene, Wilburn
Type of Marker: Title Corner cut 'x'; Record Corner Steel Pin in concrete
Method of Establishment: County: 10/4/1994
IN S.P.C. E Zone, NAD 83 (1986)
Name: 14040910

Title
N: 492 095. 480 (m)
E: 63 103. 696 (m)
Record
N: 492 098. 138 (m)
E: 63 103. 101 (m)

THIS CORNER POSITION REPRESENTS A "TITLE" CORNER AND MAY NOT NECESSARILY REPRESENT THE POSITION BASED ON RECORD CORNERS.

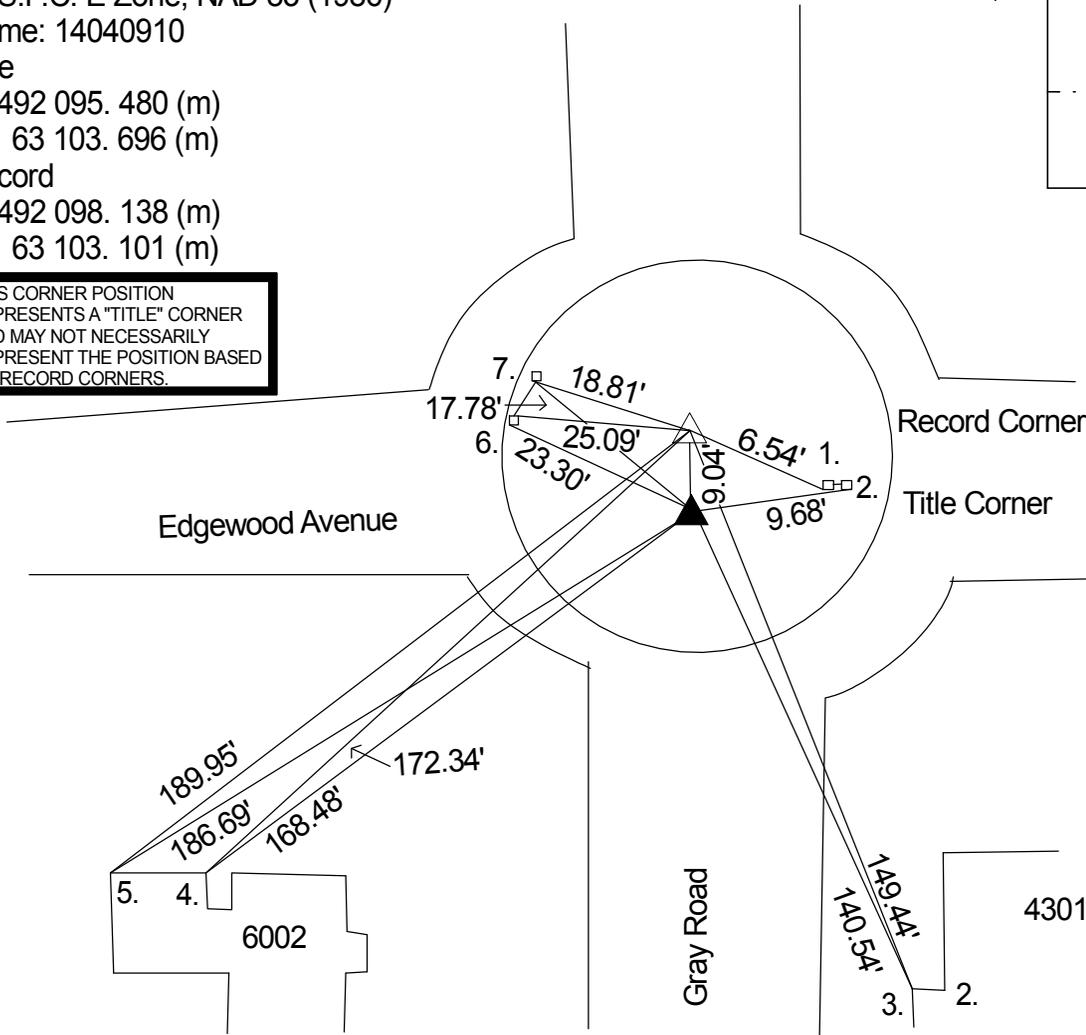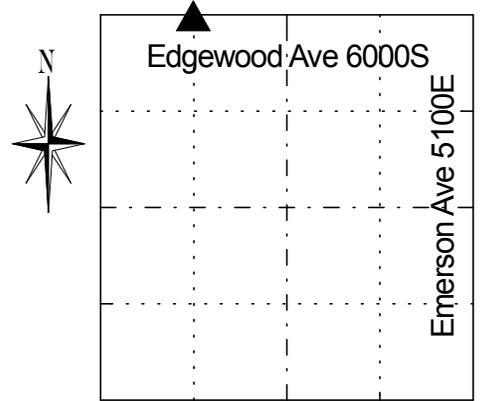

TITLE CORNER

D.B. Hosbrook 4/24/1851 noted corner with witnesses: 4" W. Beech N 80 ½°W 35 links, 22" Beech S 19°W 55 links (Perry Twp. Legal Survey Book pg. 22). Percy Hosbrook 6/21/1851 surveyed east-west road (Perry Twp. Legal Survey Book pg. 20). D.B. Hosbrook 3/6/1855 noted distances to corner (Perry Twp. Legal Survey Book pg. 31). Wm. P. Smith 3/19/1868 noted corner with witnesses: 4" Beech N 80 ½°W 35 links, 22" Beech S 19°W 55 links, 12" Beech S 55 ½°E 73 ¼ links (Perry Twp. Legal Survey Book pg. 31). Chas. P. Culley 3/1/1899 noted Stone (Perry Twp. Legal Survey Book pg. 21). Herbert Bloemker / Arthur F. Haufler 12/13/1935-3/11/1936 noted corner (Perry Twp. Legal Survey Book pg. 78). F.F. Unversaw undated called RR Spike in centerline 'X'. A. Cleveland 5/13/1980 called RR Spike 4" down. A. Cleveland 3/24/1981 called RR Spike. Gries 6/25/1987 called RR Spike. Wilcoxon 10/4/1994 set PK Nail. Wilcoxon 4/24/2000 found PK Nail. Wilcoxon 8/8/2007 set Survey Mark Nail. Wilcoxon 6/23/2015 cut 'X' in sidewalk.

RECORD

F.F. Unversaw undated called Nail 9.15' north. Dick Long 5/11/1955 added note to Unversaw tie that the Boat Spike was on line between ¼ corners. Fortner 5/21/1975 excavated, did not find Stone, set Road Nail at midpoint of line between northwest and north quarter corners. A. Cleveland 5/13/1980 noted record corner 9.15' north. A. Cleveland 3/24/1981 called Road Nail. Gries 6/25/1987 called Road Nail. Wilcoxon 10/4/1994 set PK Nail. Wilcoxon 4/24/2000 set PK Nail. Wilcoxon 8/8/2007 called PK Nail. Wilcoxon 6/22/2015 found Steel Pin in concrete.

	TITLE	RECORD	
REF	DISTANCE	DISTANCE	DESCRIPTION
1.		6.54'	SW corner sign post
2.	9.68'		SE corner sign post
3.	140.54'	149.44'	NW garage corner Address 4301
4.	168.48'	172.34'	NE garage corner Address 6002
5.	186.69'	189.95'	NW garage corner Address 6002
6.	23.30'	17.78'	SW corner sign post
7.	25.09'	18.81'	SW corner sign post