

MARION COUNTY SURVEYOR'S OFFICE

SECTION CORNER RECORD

DEBRA S. JENKINS
MARION COUNTY SURVEYOR

BRYAN F. CATLIN, PLS
TECHNICAL SUPERVISOR



SEC. 6 TWN. 14_N RNG. 5_E

SEC. 1 TWN. 14_N RNG. 4_E

SEC. 31 TWN. 15_N RNG. 5_E

SEC. 36 TWN. 15_N RNG. 4_E

Date: 4-10-10
Party Chief: Greene
Crew: Taylor
Type of Marker: Harrison
Method of Establishment: County: 7-26-1996
IN S.P.C. E Zone, NAD 83 (1986)
Name: 14050601; 14040103; 15053107; 15043609
N: 493 814.517(m)
E: 69 221.726(m)

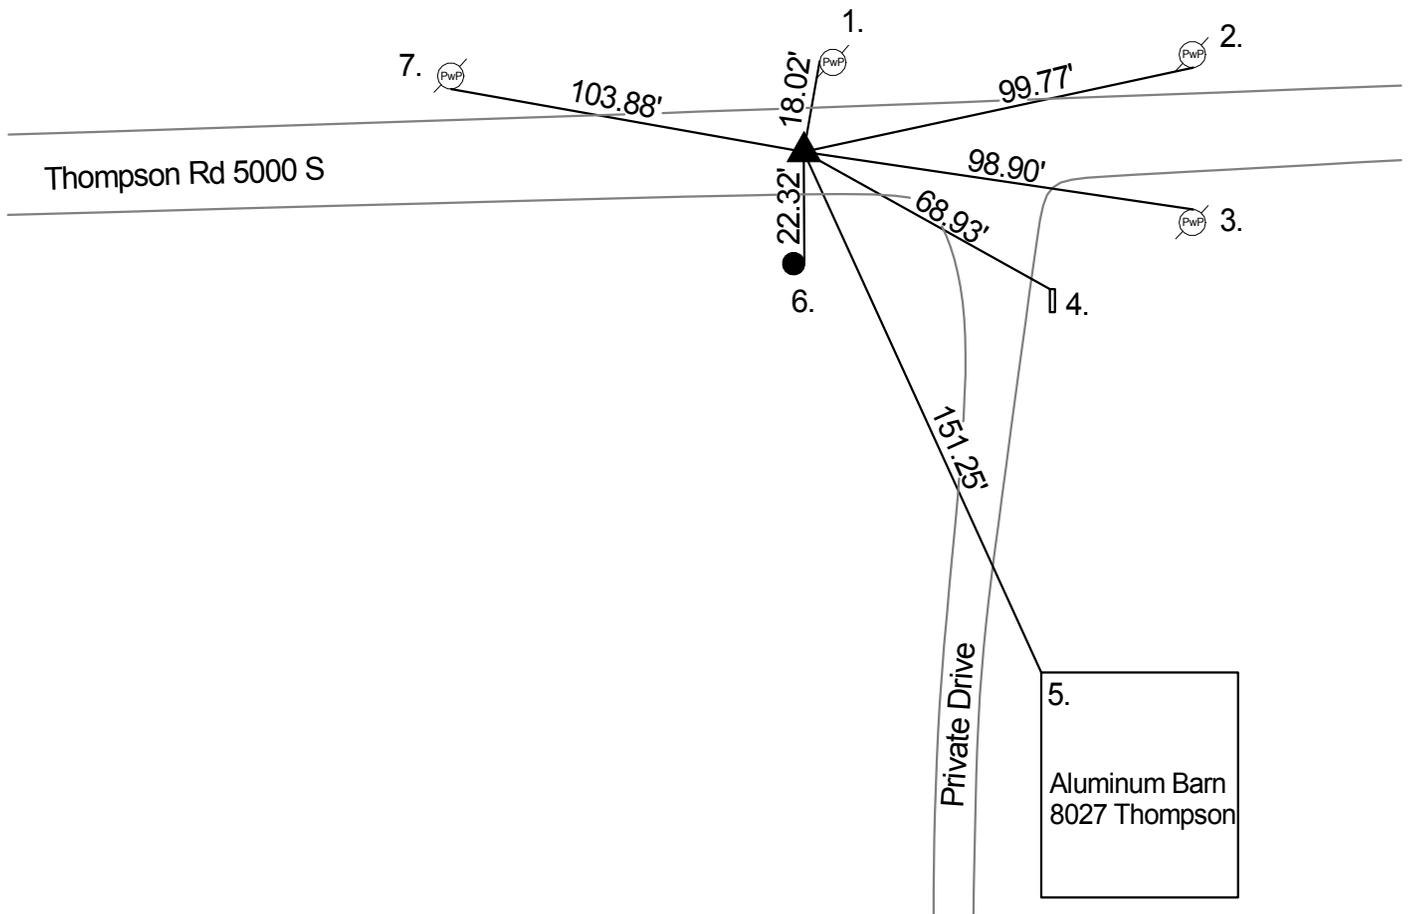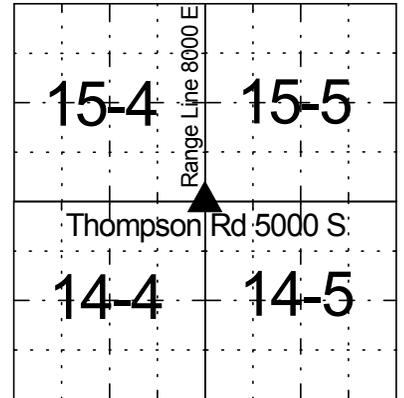

Original post set August 1, 1819 by John McDonald with witnesses: 18" Beech S 85°E 35 links, 20" Lynn S 67°W 12 links (Marion County Atlas p. 14). P. Hosbrook 11/12-15/1850 notes "witness all gone set a thundering Rock" with witnesses: 20" Lynn North 142 links, 20" Lynn N 55°E 73 links (Franklin Twp. Legal Survey Book pg. 34). D.B. Hosbrook 12/20/1852 noted corner with witness: 20" Lynn North 142 links (Franklin Twp. Legal Survey Book pg. 18). D.B. Hosbrook 11/28 & 29/1859 noted corner with witness: 10" Oak N 43°W 60 links (Franklin Twp. Legal Survey Book pg. 10). Undated MCSO ties calls stone. Monroe 11/29/1954 called iron pipe over stone. GWS 6/11/1962 called iron pipe over stone. Gorske 8/20/1970 called stone. Fortner 3/20/1975 called RR spike over stone. Green 10/13/1982 called RR spike. Greene 7/25/1986 excavated, stone found 24" down, set Harrison. Wilcoxon 8/16/1994 called Harrison. Kiste 7/26/1996 called Harrison. Whiteside 3/10/2001 called Harrison. Kiste 3/7/2006 called Harrison. Wilcoxon 6/30/2006 called Harrison. Wilcoxon 10/4/2006 called Harrison. Greene 4/10/2010 called Harrison.

REF	DISTANCE	DESCRIPTION
1.	18.02'	PK nail W PwP #140-710 14" up
2.	99.77'	PK nail S PwP #31-710 18" up
3.	98.90'	PK nail N PwP #122-710 14" up
4.	68.93'	Face of wooden address sign (8005 Thompson)
5.	151.25'	NW corner of aluminum barn (8027 Thompson)
6.	22.32'	Due S to PK nail E wooden post 24" up
7.	103.88'	Mag nail w/washer S PwP #180-709 24" up