

MARION COUNTY SURVEYOR'S OFFICE



SECTION CORNER RECORD

DEBRA S. JENKINS
MARION COUNTY SURVEYOR

SEC. 8 TWN. 14_N RNG. 5_E

BRYAN F. CATLIN, PLS
TECHNICAL SUPERVISOR

Date: 6/1/2011
Party Chief: Greene
Crew: Schermerhorn
Type of Marker: Harrison
Method of Establishment: County: 7/17/1998
IN S.P.C. E Zone, NAD 83 (1986)
Name: 14050801
N: 492 222. 529 (m)
E: 70 630. 102 (m)

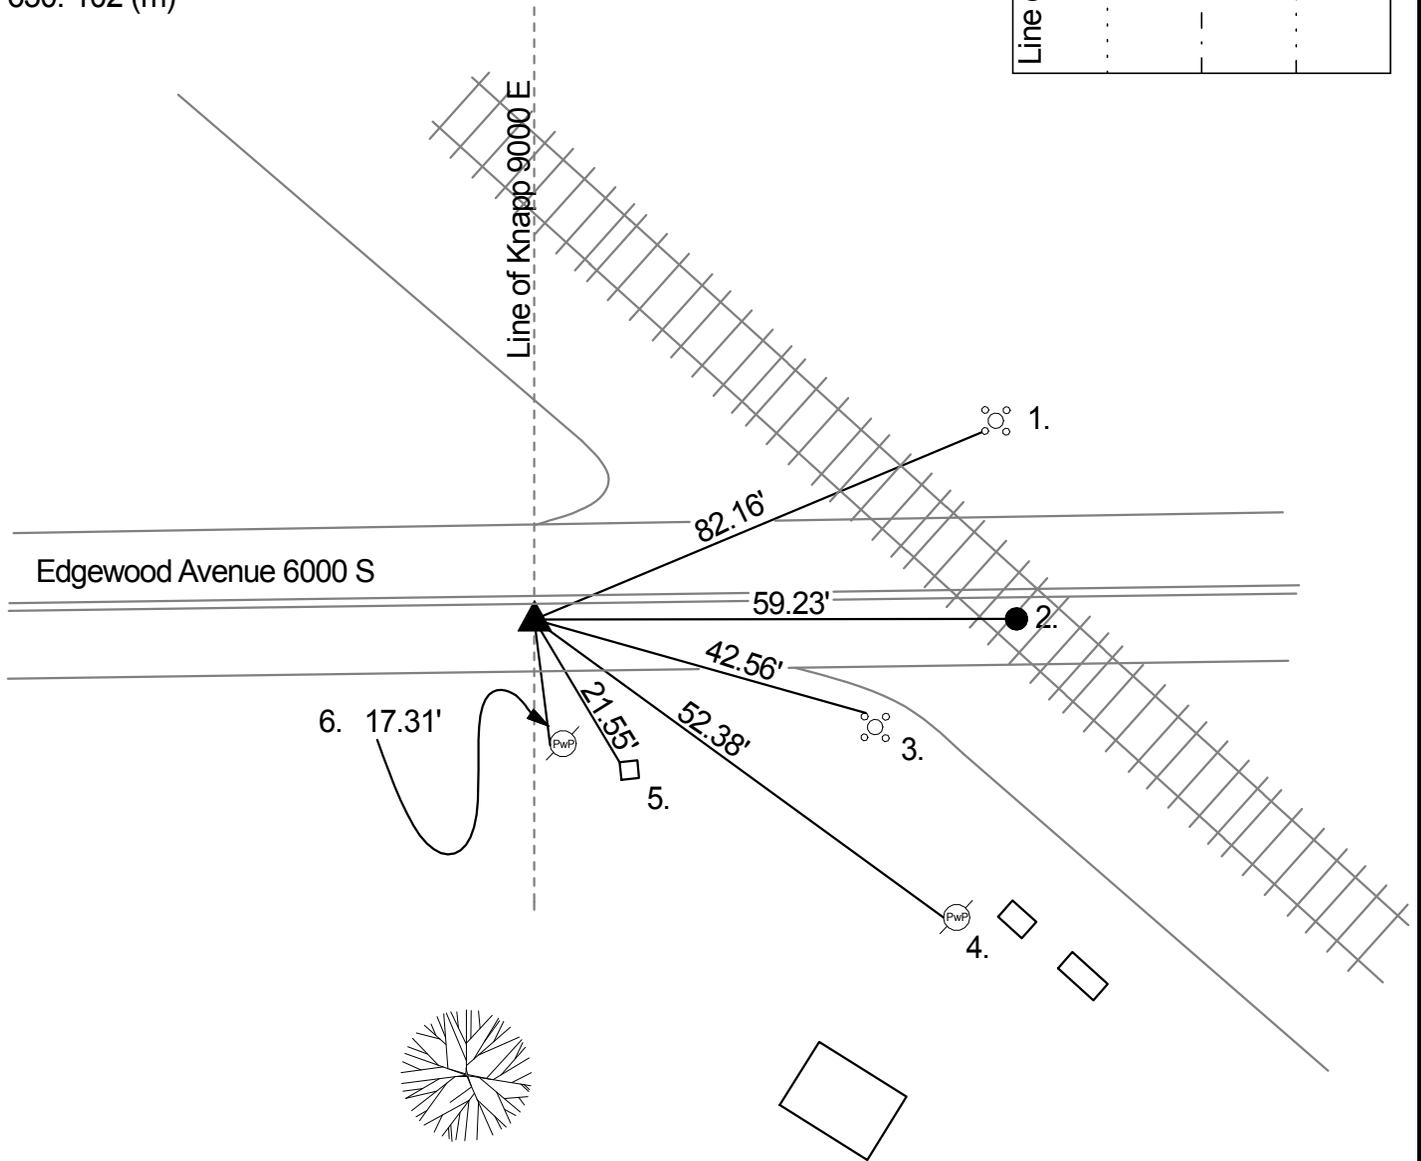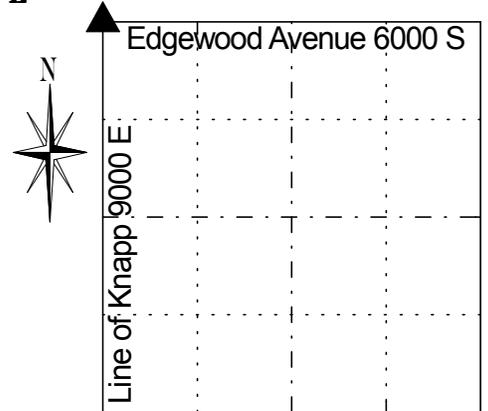

Original post set in 1820 by John Hendricks with witnesses: 12" Beech N 28°W 37 links, 16" Beech S 30°W 9 links (Marion County Atlas pg. 13). P. Hosbrook 11/12-15/1850 noted "all gone" with witnesses: 15" Oak S 83°W 50 links, 20" Ash N 73°E 18 links and "set Rock to nearly ... all of the corners" (Franklin Twp. Legal Survey Book pg. 34). P. Hosbrook 6/17/1851 "found witness trees" (Franklin Twp. Legal Survey Book pg. 34). Wm. P. Smith 3/10&11/1866 noted "Stump of one original no witness" and "qualified men to place stones" (Franklin Twp. Legal Survey Book pg. 33). MCSO undated did not specify monument. McLand 4/9/1970 called RR Spike. Fortner 11/14/1974 called RR Spike 2" down. Greene 5/22/1987 called RR Spike 2" down. Wilcoxon 6/21/1993 excavated, RR Spike 2" down, 2" steel pipe 36" long 12" down, set Harrison. Wilcoxon 7/17/1998 called Harrison. Wilcoxon 10/15/2002 called Harrison. Wilcoxon 1/17/2007 called Harrison. Greene 6/1/2011 reset Harrison to replace broken Harrison.

REF	DISTANCE	DESCRIPTION
1.	82.16'	Cut 'x' SW bolt of railroad crossing signal base
2.	59.23'	Due E C/L of railroad crossing
3.	42.56'	Cut 'x' NW bolt of railroad crossing signal base
4.	52.38'	PK nail W PwP no # 20" up
5.	21.55'	W corner of concrete R/W post
6.	17.31'	PK nail W PwP #79-741 12" up