

MARION COUNTY SURVEYOR'S OFFICE



SECTION CORNER RECORD

DEBRA S. JENKINS
MARION COUNTY SURVEYOR

SEC. 1 TWN. 15_N RNG. 2_E

BRYAN F. CATLIN, PS
TECHNICAL SUPERVISOR

Date: 10/17/2014
Party Chief: Wilcoxon
Crew: FitzPatrick
Type of Marker: Copper Plug
Method of Establishment: County: 7/27/1997
IN S.P.C. E Zone, NAD 83 (1986)
Name: 15020104
N: 502 371. 615 (m)
E: 48 315. 915 (m)
Name: 15020104A (Copper Plug)
N: 502 371. 600 (m)
E: 48 310. 179 (m)
Name: 15020104B (Copper Plug)
N: 502 371. 605 (m)
E: 48 295. 509 (m)

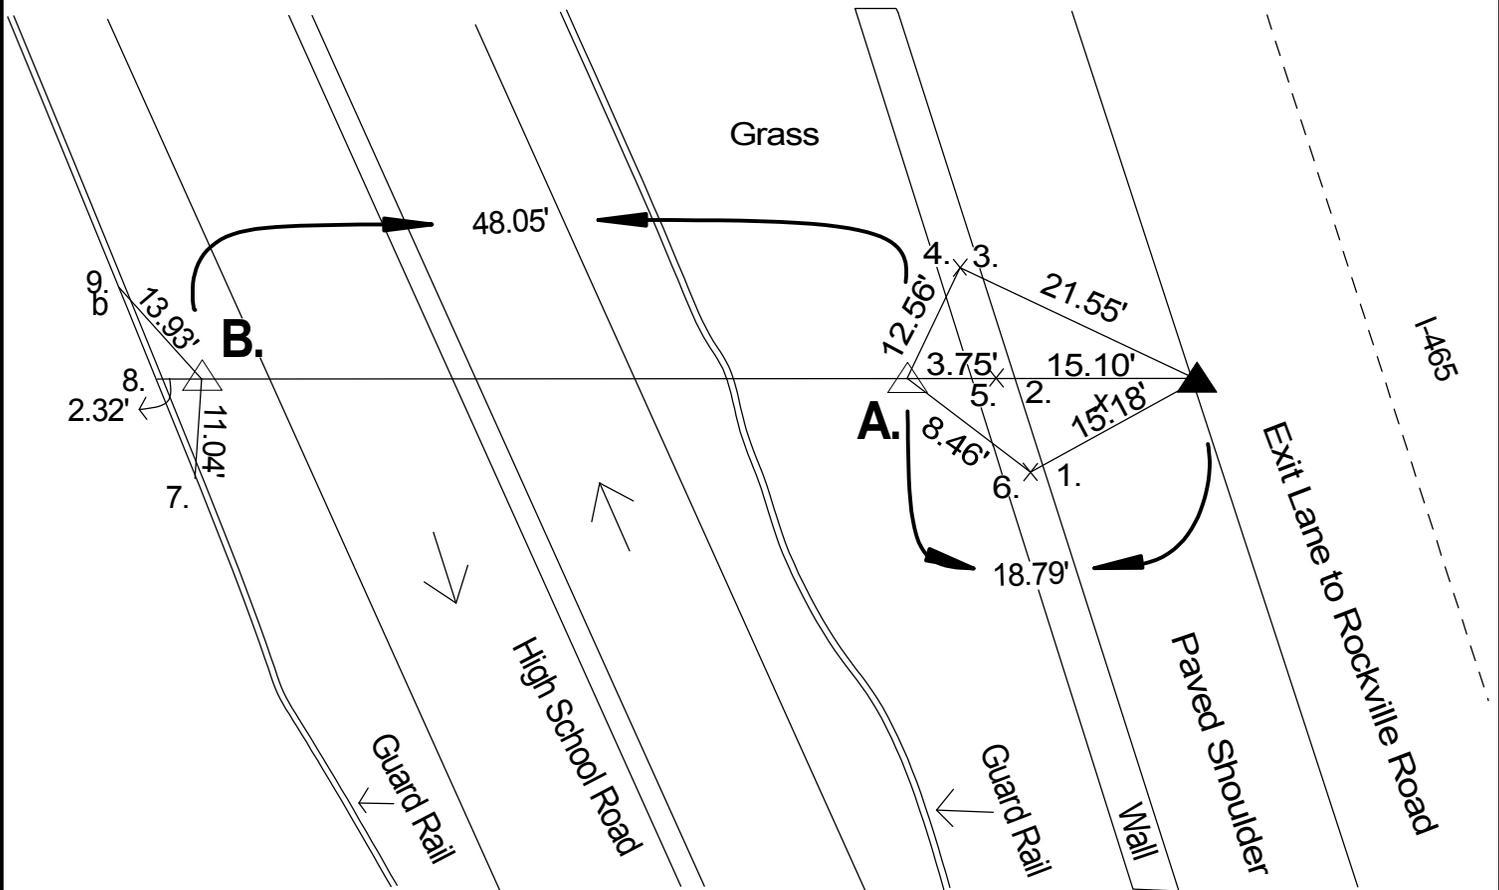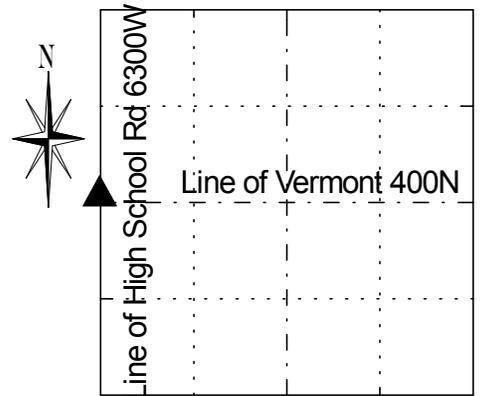

Original post set in 1820 by Wm. B. Laughlin with witnesses: 10" Sugar S 74°W 43 links, 4" Sugar N 69°E 21 links (Marion Co. Atlas pg. 2). D.B. Hosbrook 3/26/1855 noted no witnesses, set corner by proportion and noted "Rock two links South of corner" (Wayne Twp. Legal Survey Book pg. 21). Wm. P. Smith 5/16/1866 noted Rock by Rock 3 ft. 9 by 3 S 4 1/2°W 46 (56?) links (Wayne Twp. Legal Survey Book pg. 23, notes Book 1, pg. 312). H.B. Fatout 2/1877 surveyed east-west road (Wayne Twp. Legal Survey Book pg. 21). H.B. Fatout 4/30/1877 noted distances to corner (Wayne Twp. Legal Survey Book pg. 21). H.B. Fatout 3/20/1878 noted distances to corner (Wayne Twp. Legal Survey Book pg. 21). Thompson 2/3/1948 called RR Spike. Wilcoxon/Bruer 4/10/1980 found Rebar per deeds "and in agreement with 1/4 1/4 distance between C 1/4 cor. and N 1/4 1/4 SE 1/4". Wilcoxon 8/28/1989 found Rebar. Wilcoxon 7/27/1997 found 1/2" Rebar. Wilcoxon 6/16/2003 found 1/2" Rebar. INDOT/Walsh Construction 10/17/2014 set Copper Plug per MCSO staking by coordinates due to I-465 widening (CP 0047, STA 712+49.82 "PR-HH", 85.77' Lt., Proj. IM-465-4 (356), Sht. 37 of 251, DES 9829410).

REF	DISTANCE	DESCRIPTION
1.	15.18'	Cut 'x' on top concrete retaining wall
2.	15.10'	Cut 'x' on top concrete retaining wall
3.	21.55'	Cut 'x' on top concrete retaining wall
4.	12.56'	Cut 'x' on top concrete retaining wall
5.	3.75'	Cut 'x' on top concrete retaining wall
6.	8.46'	Cut 'x' on top concrete retaining wall
7.	11.04'	NE corner I-beam
8.	2.32'	SE corner I-beam
9.	13.93'	SE corner I-beam