

MARION COUNTY SURVEYOR'S OFFICE



SECTION CORNER RECORD

DEBRA S. JENKINS
MARION COUNTY SURVEYOR

SEC. 12 TWN. 16_N RNG. 2_E

BRYAN F. CATLIN, PLS
TECHNICAL SUPERVISOR

Date: 10/28/2011
Party Chief: Wilcoxon
Crew: Greene / Schermerhorn
Type of Marker: Harrison
Method of Establishment: County: 10/3/1994
IN S.P.C. E Zone, NAD 83 (1986)
Name: 16021204
N: 510 539.499 (m)
E: 48 295.052 (m)

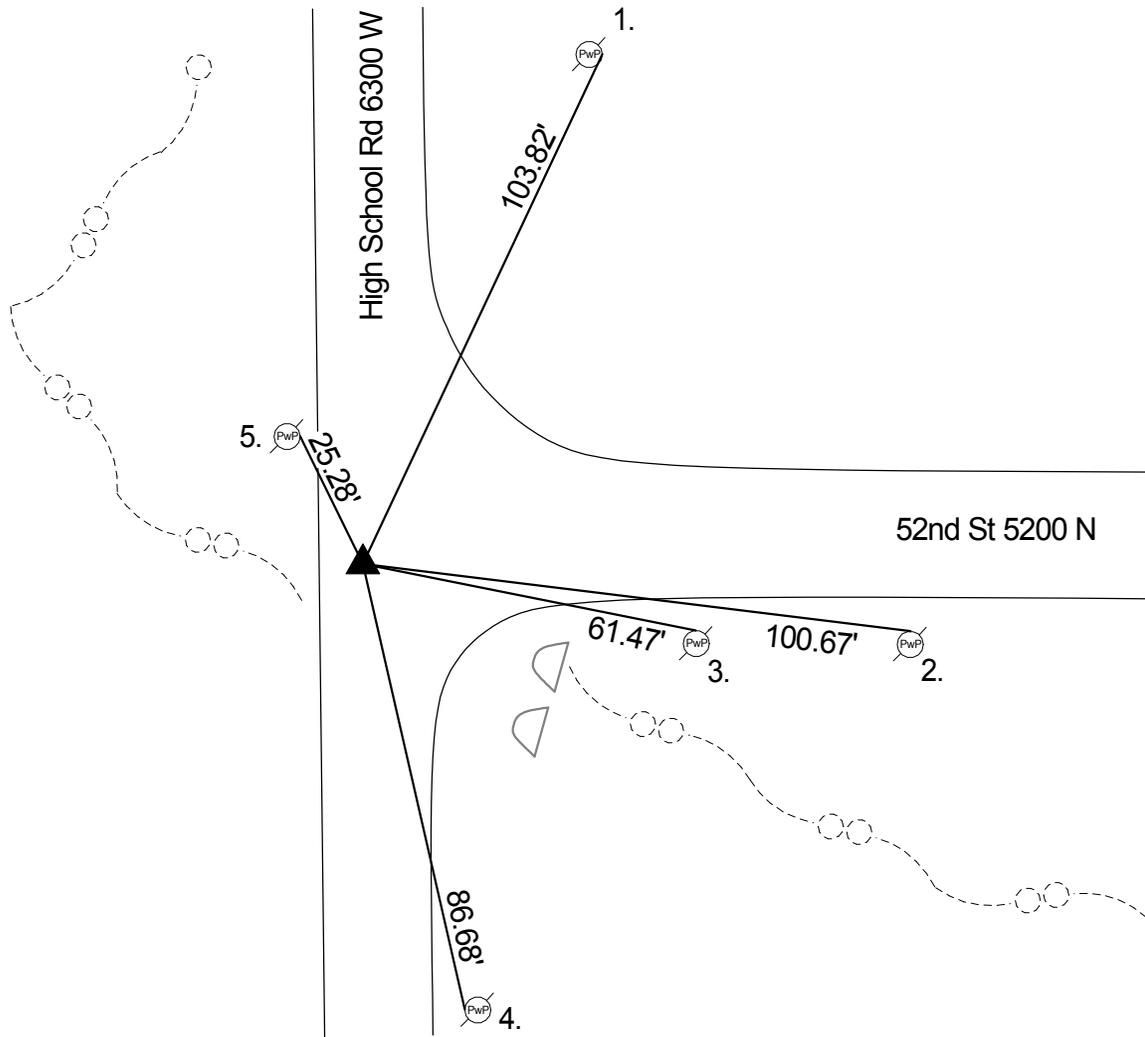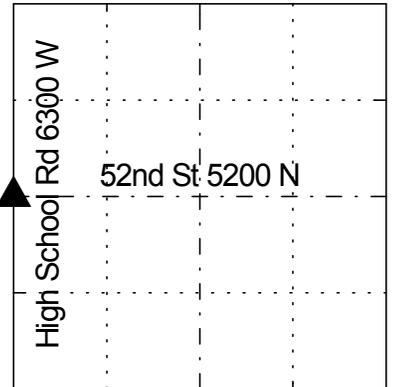

Original post set in 1820 By Wm. B. Laughlin with witnesses: 20" Sugar S 88°E 47 links, 12" Sugar N 76°W 43 links (Marion County Atlas pg. 3). D.B. Hosbrook 8/9/1854 "set Rock" (Pike Twp. Legal Survey Book pg. 27). H.B. Fatout 1/7/1886 noted distance to corner (Pike Twp. Legal Survey Book pg. 5). MCSO undated called Stone. Harris 6/14/1955 found Stone. Monroe 7/31/1959 called Steel Pin over Stone 4" down. McLand 4/12/1970 called PK Nail. Howe 3/15/1973 called PK Nail. McLand 1/28/1975 found PK Nail. Green 9/9/1985 found PK Nail. Kiste 10/3/1994 called RR Spike in concrete. Wilcoxon 6/13/1999 called RR Spike in concrete. Wilcoxon 9/20/2005 called RR Spike in concrete. Greene 10/28/2011 excavated, found RR Spike 5" down, nothing else found due to pipe under road, set Harrison.

REF	DISTANCE	DESCRIPTION
1.	103.82'	PK nail E PwP #41-324B 10" up
2.	100.67'	PK nail N PwP #244-354A 8" up
3.	61.47'	PK nail N PwP #66-354A 24" up
4.	86.68'	Mag nail W PwP #65-354A 12" up
5.	25.28'	PK nail E light pole #37-323B 18" up