

MARION COUNTY SURVEYOR'S OFFICE


SECTION CORNER RECORD

DEBRA S. JENKINS
MARION COUNTY SURVEYOR


SEC. 2 TWN. 16_N RNG. 3_E

BRYAN F. CATLIN, PS
TECHNICAL SUPERVISOR

Date: 11/3/2016
Party Chief: Pangelinan
Crew: Wilburn/Bronson
Type of Marker: 1" Pipe
Method of Establishment: County: 9/1/1992
IN S.P.C. E Zone, NAD 83 (1986)
Name: 16030202
N: 513 019. 272 (m)
E: 57 003. 919 (m)

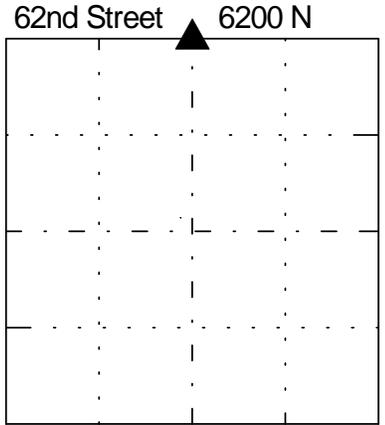

THIS CORNER POSITION REPRESENTS A "TITLE" CORNER AND MAY NOT NECESSARILY REPRESENT THE POSITION BASED ON RECORD CORNERS.

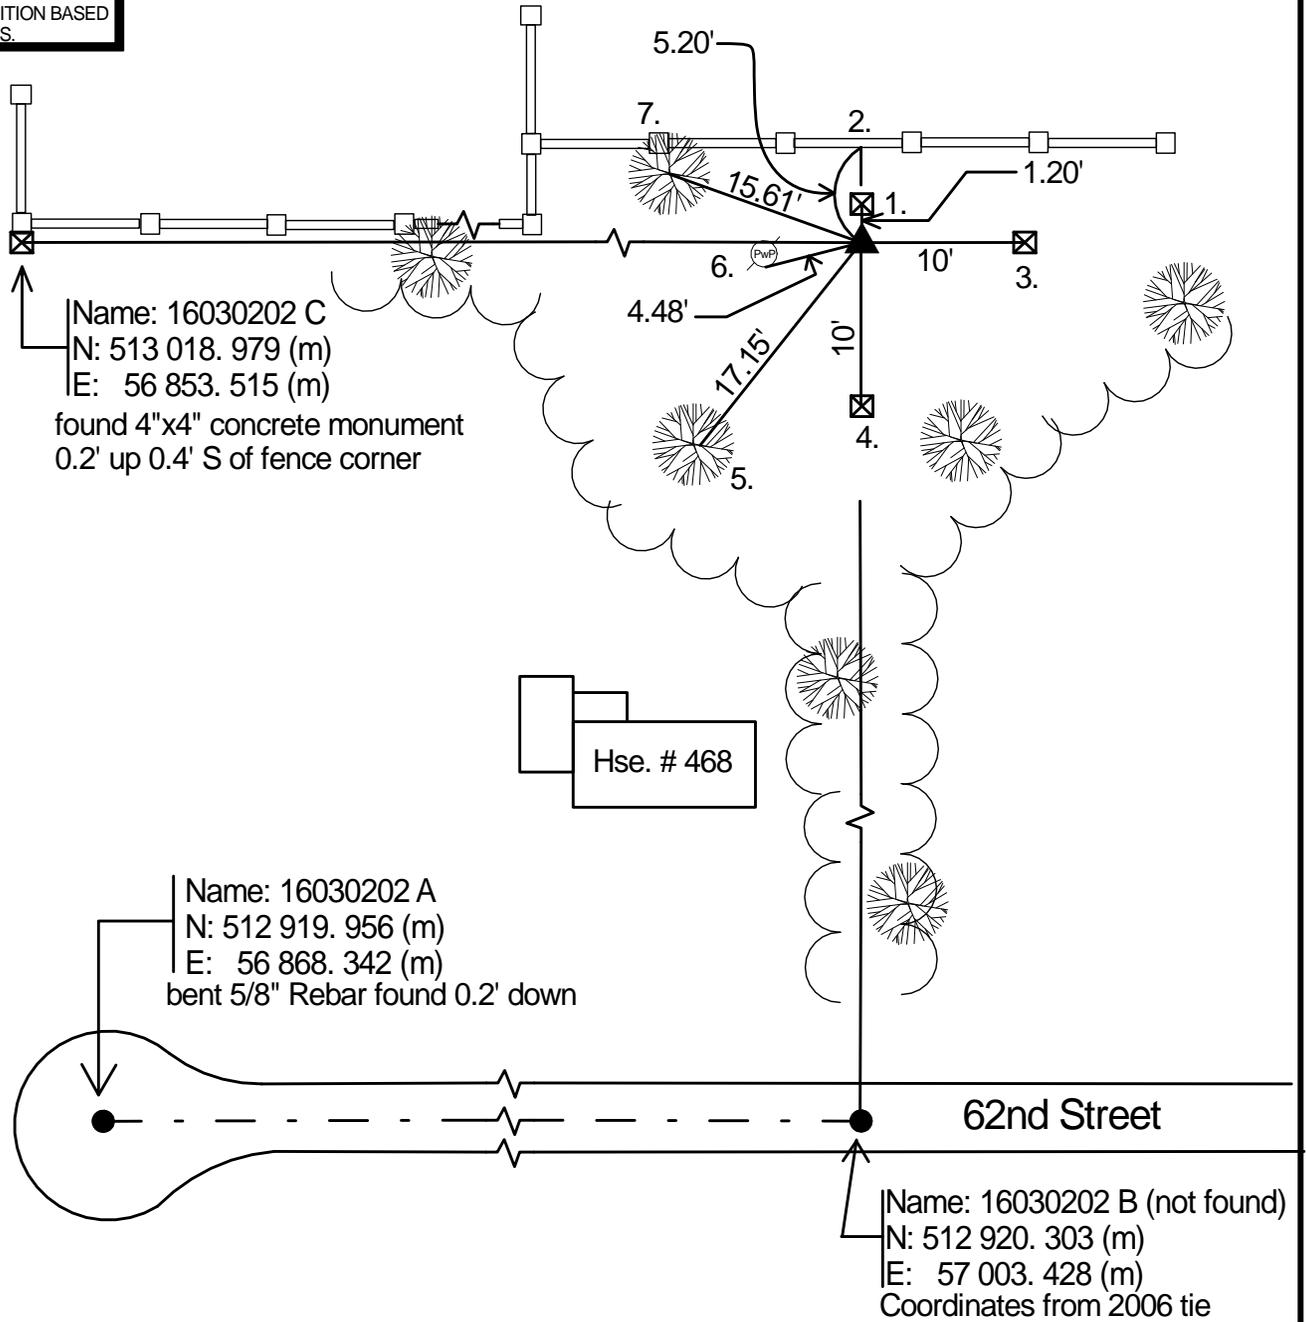

D.H. Fatout 5/8/1883 noted distances to corner (Washington Twp. Legal Survey Book pg. 84). John J. Griffith / F.P. Joyce 5/2/1924 found '2 Cut Stones at "B", one set 10' E. of the true corner, and the other is 10' S. The original corner is gone' (Washington Twp. Legal Survey Book pg. 120). Wilcoxen / Whiteside 9/1/1992 set 1" Pipe. Kiste 12/1/1999 found 1" Pipe. Kiste 9/25/2006 found 1" Pipe. Pangelinan 11/3/2016 found 1" Pipe 5" up.

REF	DISTANCE	DESCRIPTION
1.	1.20'	Due N to found concrete monument 1.2' N & 0.1' W of 1" iron pipe
2.	5.20'	Due N to face of wooden fence
3.	10.0'	Due E to cut "X" limestone marker
4.	10.0'	Due S to cut "X" limestone marker
5.	17.15'	PK Nail w/washer NE 10" Pignut Hickory 8" up
6.	4.48'	PK Nail SE PwP # 132-305 B 8" up
7.	15.61'	Large Road Nail w/washer S 20" wild Cherry 6" up