

# MARION COUNTY SURVEYOR'S OFFICE


## SECTION CORNER RECORD

DEBRA S. JENKINS  
MARION COUNTY SURVEYOR


SEC. 36 TWN. 17<sub>N</sub> RNG. 3<sub>E</sub>

BRYAN F. CATLIN, PLS  
TECHNICAL SUPERVISOR

Date: 5/22/2012  
Party Chief: Wilcoxon  
Crew: Greene  
Type of Marker: Rebar  
Method of Establishment: County: 11/2/2005  
IN S.P.C. E Zone, NAD 83 (1986)  
Name: 170336C  
N: 514 658. 902 (m)  
E: 60 155. 555 (m)

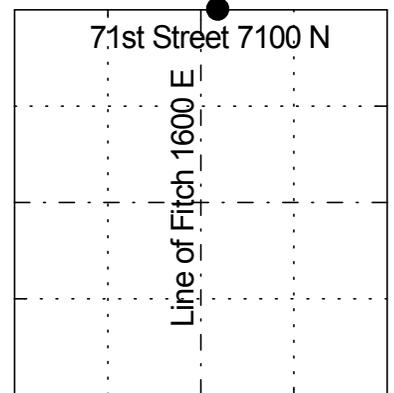

THIS CORNER POSITION REPRESENTS A "TITLE" CORNER AND MAY NOT NECESSARILY REPRESENT THE POSITION BASED ON RECORD CORNERS.

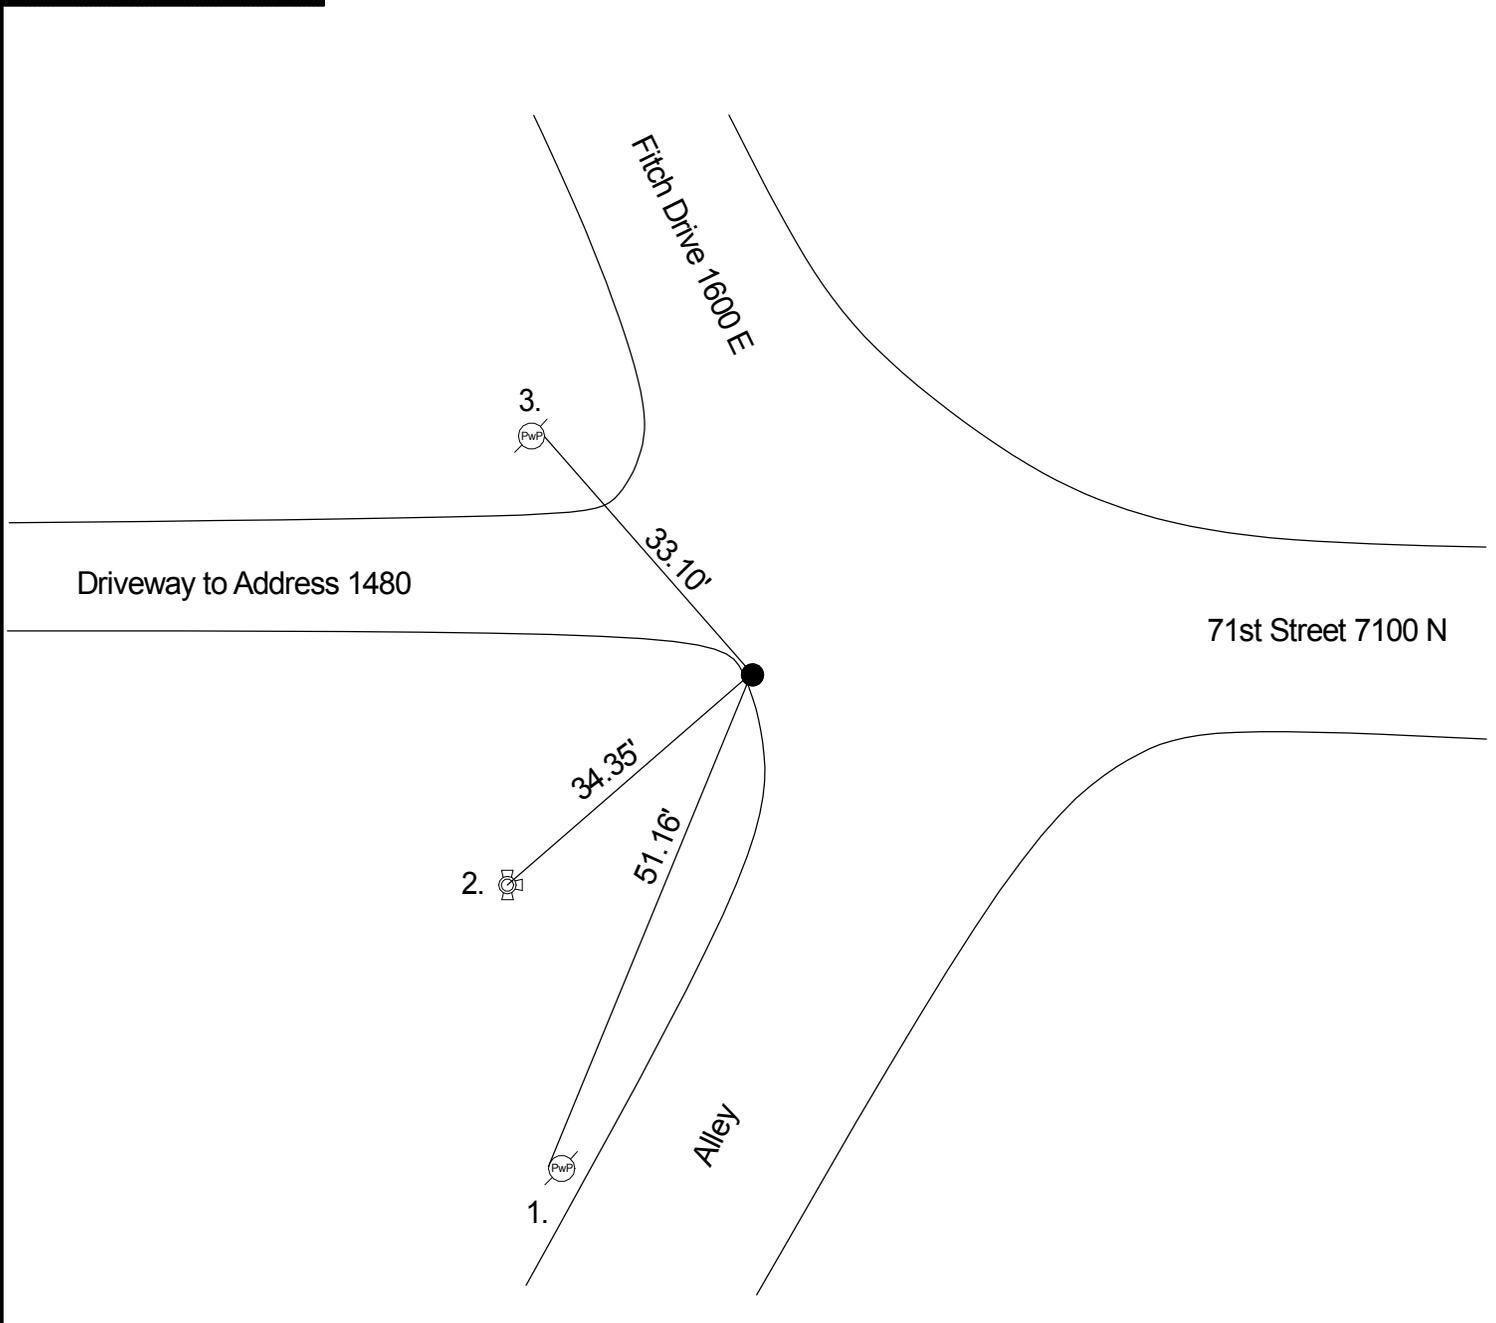

Kiste 11/2/2005 set Rebar per MCSO job #050015 Staam Park, Drawer 62, Drawing 526. Wilcoxon 5/22/2012 found Rebar.

REF	DISTANCE	DESCRIPTION
1.	51.16'	MAG Nail with washer W PwP #67-268 B 30" up
2.	34.35'	Top nut of fire hydrant
3.	33.10'	MAG Nail with washer E PwP #78-268 A 6" up