OFFICE OF THE MARION COUNTY SURVEYOR
SECTION RECORD CORNER
SECTION 14 TOWNSHIP 14 RANGE 2
DATE: 1-03-07
PARTY CHIEF: Wilcoxen
CREW:
TYPE OF MARKER: 1/2" pipe fd 8" down;set
METHOD OF ESTABLISHMENT: County: mag nail over it.

IN. S.P.C. E ZONE NAD '83
NAME: 140214F
N: 488880.8520(m)
E: 47764.8270(m)

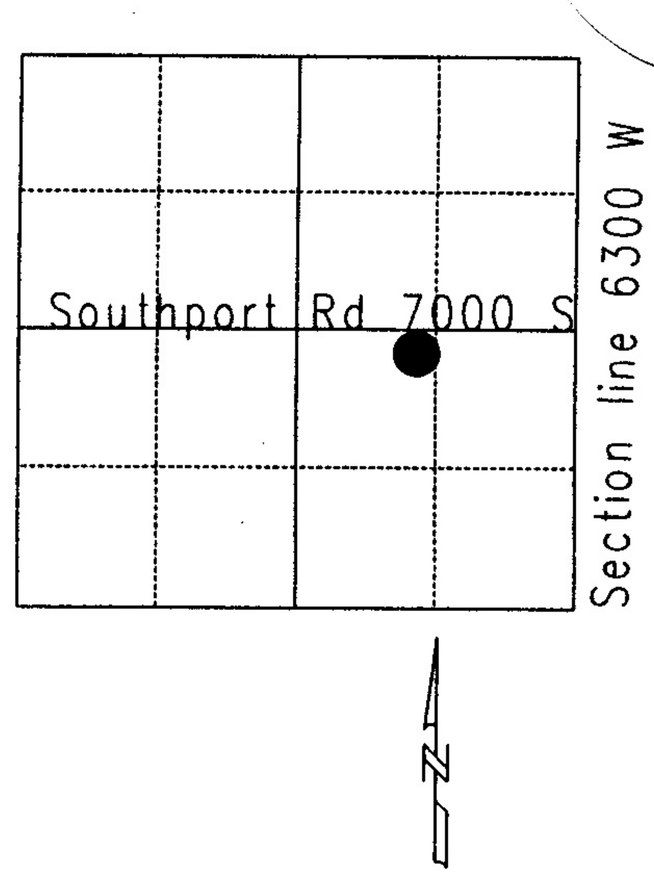

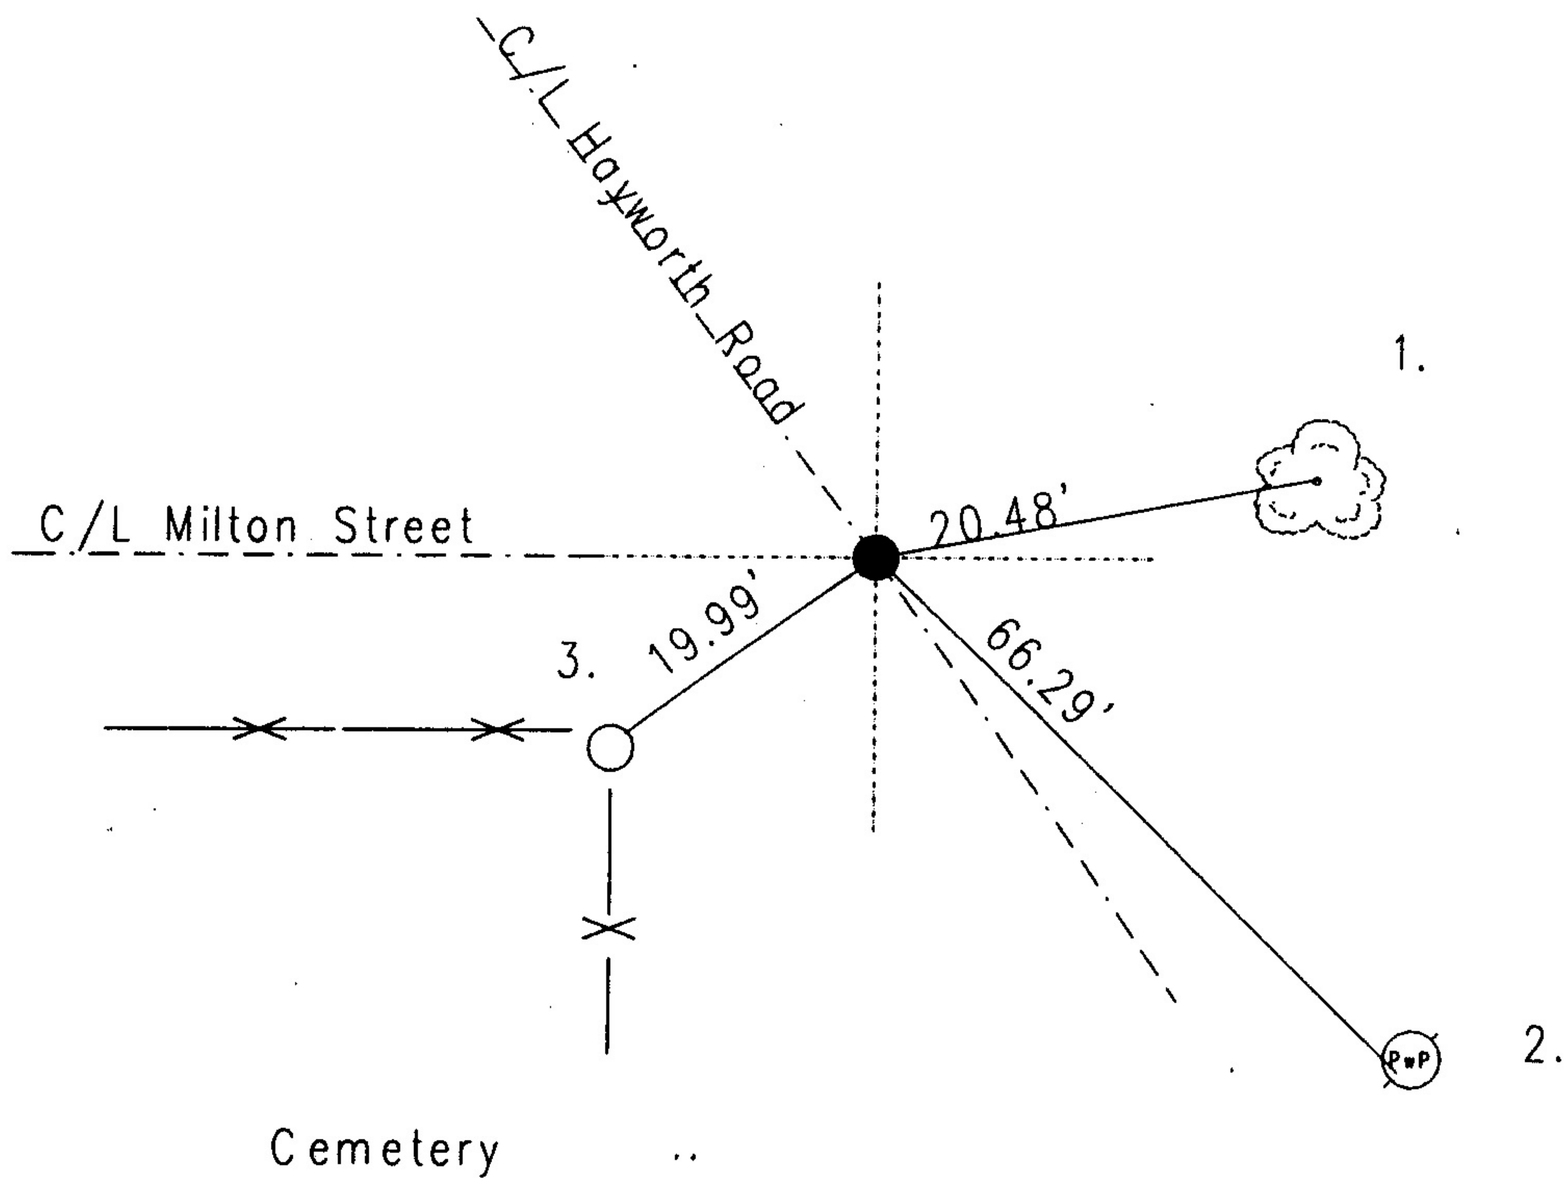

140214F

REF.	DISTANCE	DESCRIPTION
1.	20.48'	Mag nail w/bw S side 10" scrub tree 12"up
2.	66.29'	Mag nail w/bw W telephone post 12"up
3.	19.99'	Face of the most southerly steel fence post