OFFICE OF THE MARION COUNTY SURVEYOR
SECTION RECORD CORNER
SECTION 24 TOWNSHIP 14 RANGE 2
DATE: ~~10-13-99~~ 1-28-05
PARTY CHIEF: ~~Kiste~~ Wilcoxen
CREW:
TYPE OF MARKER: 5/8 " capped rebar FD
METHOD OF ESTABLISHMENT: County 12-21-94

IN. S.P.C. E ZONE, NAD 83
NAME: 14022406
N: 487826.2776(m)
E: 49915.7866(m)

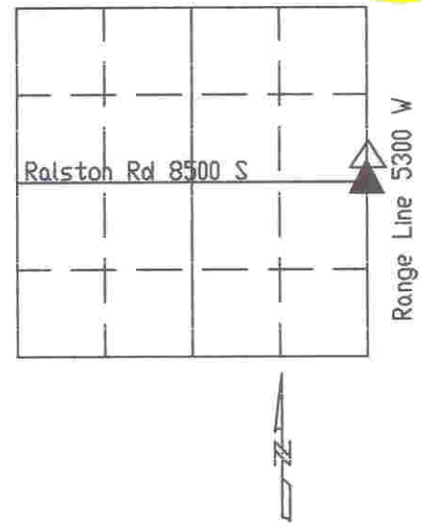

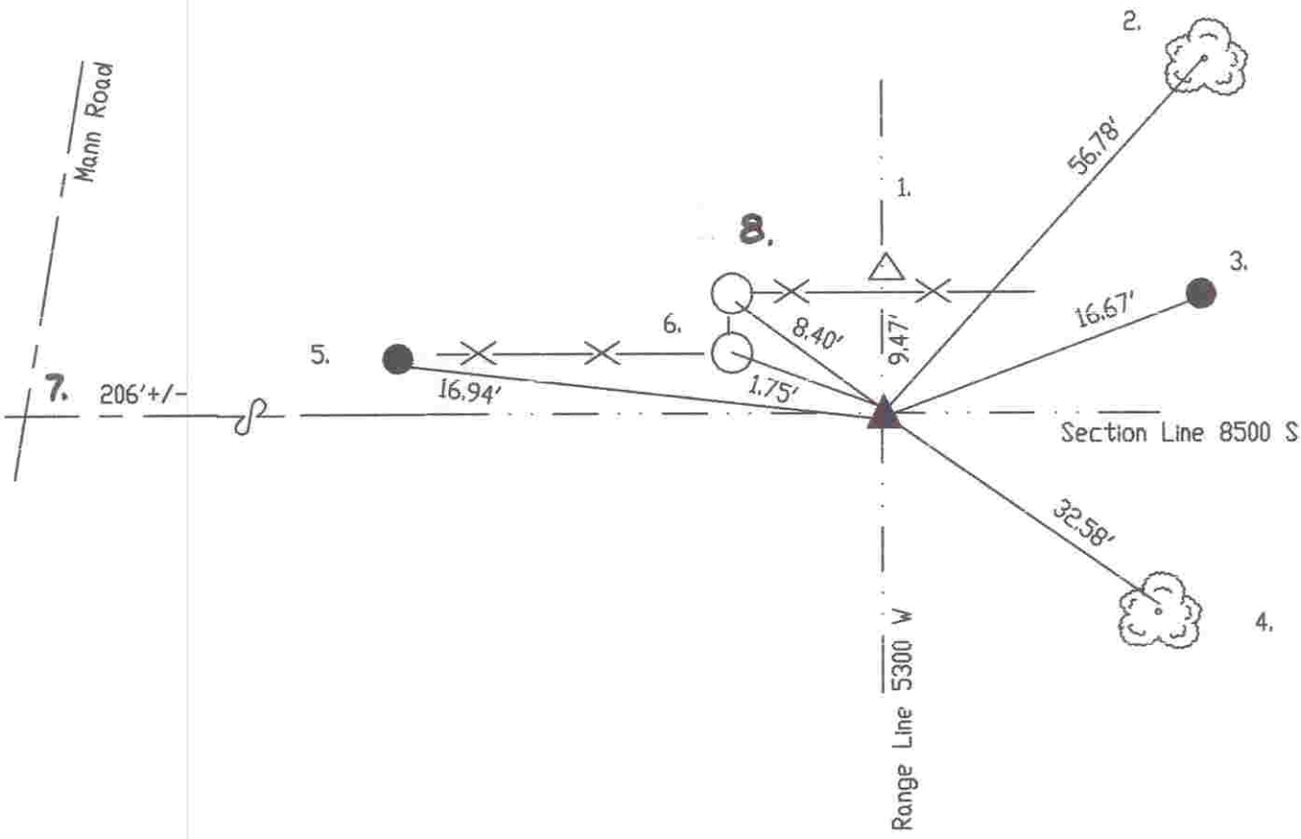

SC422406

REF.	DISTANCE	DESCRIPTION
1.	9.47'	Due N to W Q 19-14-3 (1/2" rebar)
2.	56.78'	Road nail NW 36" multi hedgeapple 12"up
3.	16.67'	1" rebar in fence line
4.	32.58'	Mag nail w/MCS washer NE 6" ash 6"up
5.	16.94'	5/8" rebar in fence line
6.	1.75'	Top center of steel corner fence post
7.	206'+/-	Due W to approximate C/L of Mann Road
8.	8.40'	Top center of steel corner fence post