OFFICE OF THE MARION COUNTY SURVEYOR
SECTION RECORD CORNER
SECTION 17 TOWNSHIP 14 RANGE 3
DATE: ~~6-13-04~~ 10-20-05
PARTY CHIEF: Wilcoxen
CREW:
TYPE OF MARKER: Harrison
METHOD OF ESTABLISHMENT: County: 8-2-99

IN. S.P.C. E ZONE NAD '83
NAME: 14031702
N: 490281.4135(m)
E: 52089.8853(m)

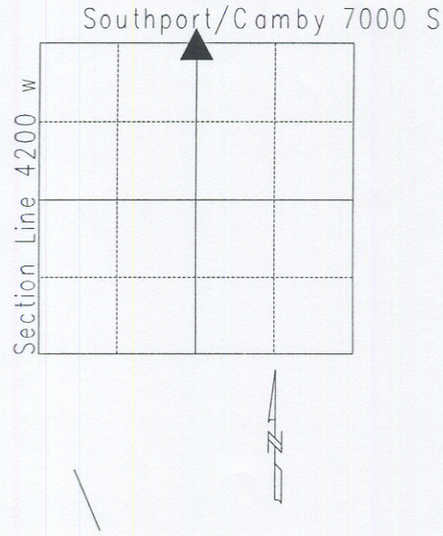

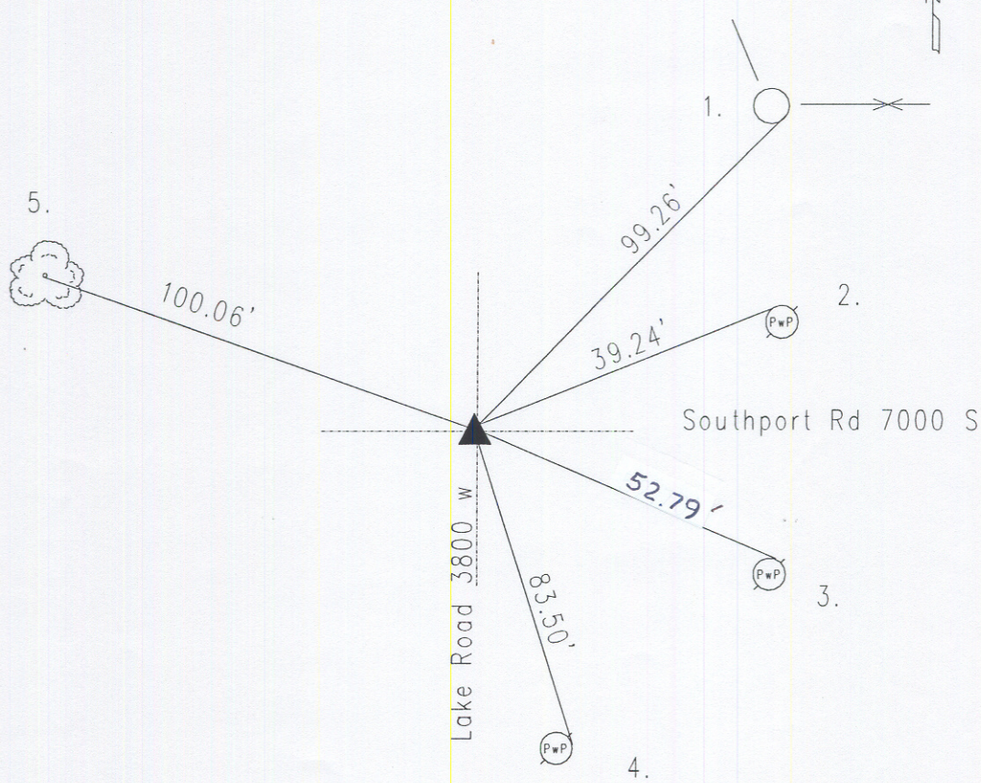

14031702

REF.	DISTANCE	DESCRIPTION
1.	99.26'	Cut 'x' SE steel fence post 24"up
2.	39.24'	Mag nail w/brass washer NW PwP#262-748 24"up
3.	52.79'	Mag nail w/brass washer NE PwP#7-749 10"up
4.	83.50'	Mag nail w/brass washer E PwP # 6-749 6"up
5.	100.06'	Barn nail w/brass washer S 30" ash 10"up

14031702 N Q corner

CORNER HISTORY: Corner originally set as a post in 1820 by Wm. B. Laughlin with witness: 6" hickory N 3 links; 4" white thorn S 30 E 11 links per Marion County Atlas pg.5. A survey 11-15-1848 noted that both witnesses: 10" walnut N 40 E 64 links and 8" walnut N 6 E 83 links were destroyed per Perry Township Legal Survey Book pages 3, 41 & 43. A survey 10-14-1850 called new witness: 30" oak N 73 W 85 links; 7" oak S 34 W 34 links per Perry Book pg. 17. A survey 11-30 thru 12-1, 1855 called witness: 14" ash N 11 ½ links; 28" oak S 60 E 40 links per Perry Book page 17. A survey 1880 by H. B. Fatout called the N Q corner as a stone per Perry Township Legal Survey Book pg. 73. Old tie card (no date) called spike over stone. Reference dated 12-10-70 by D.Day called pipe 15" down. Reference dated 2-25-72 by McLand called pipe 15" down. Reference dated 6-23-75 by Miller called a PK nail over pipe. Reference dated 11-1988 called traversed the section to locate N Q corner where old tie was 2.85'S of 'now' corner per Perry Township Legal Survey Book pg.73. Reference dated 6-13-04 by Wilcoxen called corner. Reference dated 10-11-05 by Wilcoxen called found 1" steel pin w/old hub beside it 12" down, no other points were found; set Harrison.