OFFICE OF THE MARION COUNTY SURVEYOR
SECTION RECORD CORNER
SECTION 19 TOWNSHIP 14 RANGE 3
DATE: ~~1-3-2000~~ 2-28-07
PARTY CHIEF: ~~Whiteside~~ Wilcoxen
CREW:
TYPE OF MARKER: Stone found (see note)
METHOD OF ESTABLISHMENT: County: 4-11-95

NOTE: This corner position represents a title corner and may not necessarily be in the position of the Record corner.

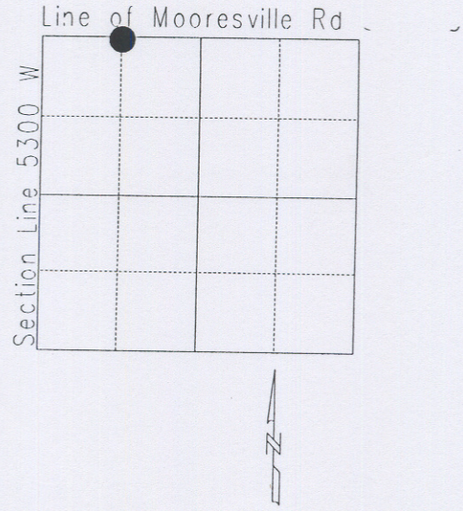

Note: Rbar set E of stone fd.

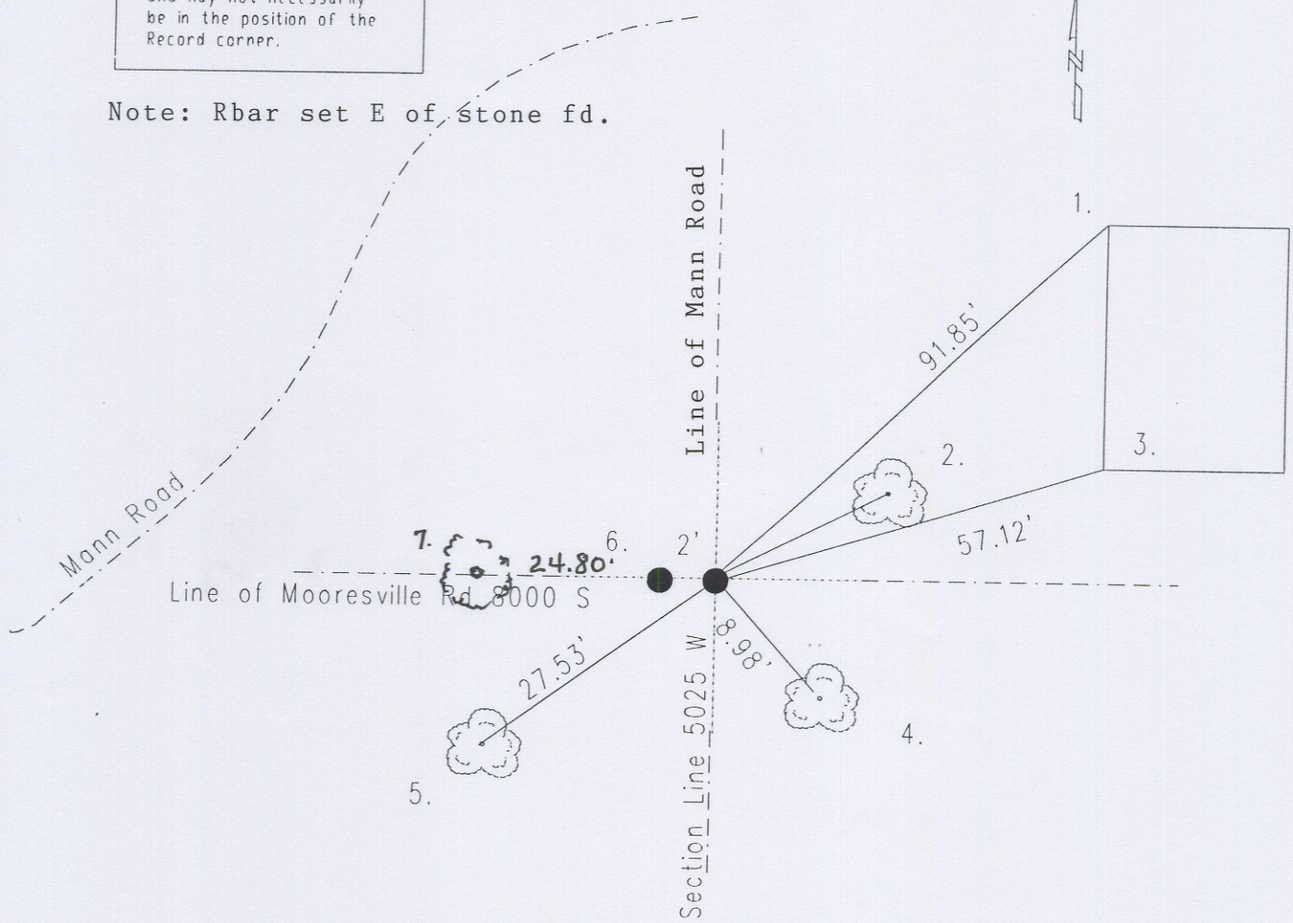

1403 1910

REF.	DISTANCE	DESCRIPTION
1.	91.85'	NW corner of 'club house"
2.	11.50'	Railroad spike S 10" hackberry ~~48"up~~ spur root
3.	57.12'	SW conrer of 'club house' at ramp/deck
4.	8.98'	Railroad spike SW 8" hackberry 15"up FOR GOLF COURSE
5.	~~27.53'~~	~~Railroad spike S 36" hackberry 18"up~~
6.	~~2.00'~~	~~Due W to rebar in fence~~
7.	24.80'	Mag nail w/bw 36" Hackberry SE side on spur root.