OFFICE OF THE MARION COUNTY SURVEYOR
SECTION RECORD CORNER
SECTION 23 TOWNSHIP 14 RANGE 3
DATE: 5-16-08
PARTY CHIEF: Wilcoxen
CREW:
TYPE OF MARKER: Tack FD:w/cut crows ft in
METHOD OF ESTABLISHMENT: County: concrete
1-29-99
IN. S.P.C. E ZONE NAD '83
NAME: 14032305
N: 487914.9410(m)
E: 56970.7660(m)

NOTE: This corner position represents a title corner and may not necessarily be in the position of the Record corner.

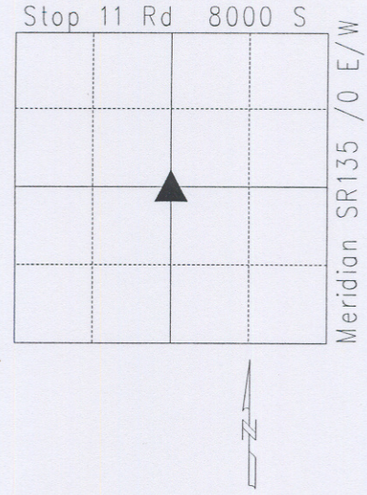

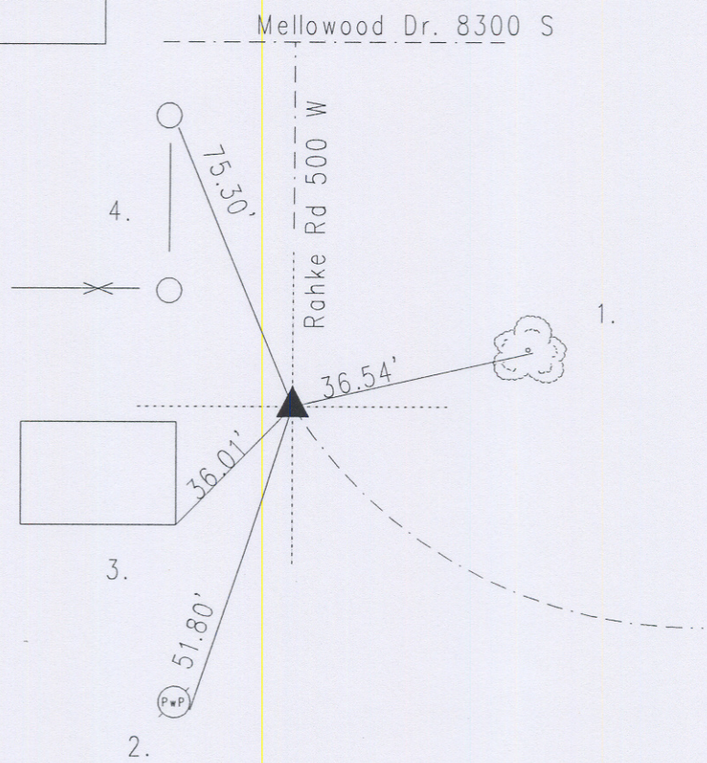

14032305

REF.	DISTANCE	DESCRIPTION
1.	36.54'	Mag nail S 24" burr oak 2"up
2.	51.80'	Mag nail w/bw SF PwP#158-814A 12"up
3.	36.01'	SF corner of wooden mini-barn
4.	75.30'	Face of steel corner fence post