OFFICE OF THE MARION COUNTY SURVEYOR
SECTION RECORD CORNER
SECTION 1 TOWNSHIP 14 RANGE 4
DATE: 4-4-05
PARTY CHIEF: Wilcoxen
CREW:
TYPE OF MARKER: Harrison
METHOD OF ESTABLISHMENT: County: 5-15-00

IN. S.P.C. E ZONE NAD '83
NAME: 14040101
N: 493762.4090(m)
E: 67588.6580(m)

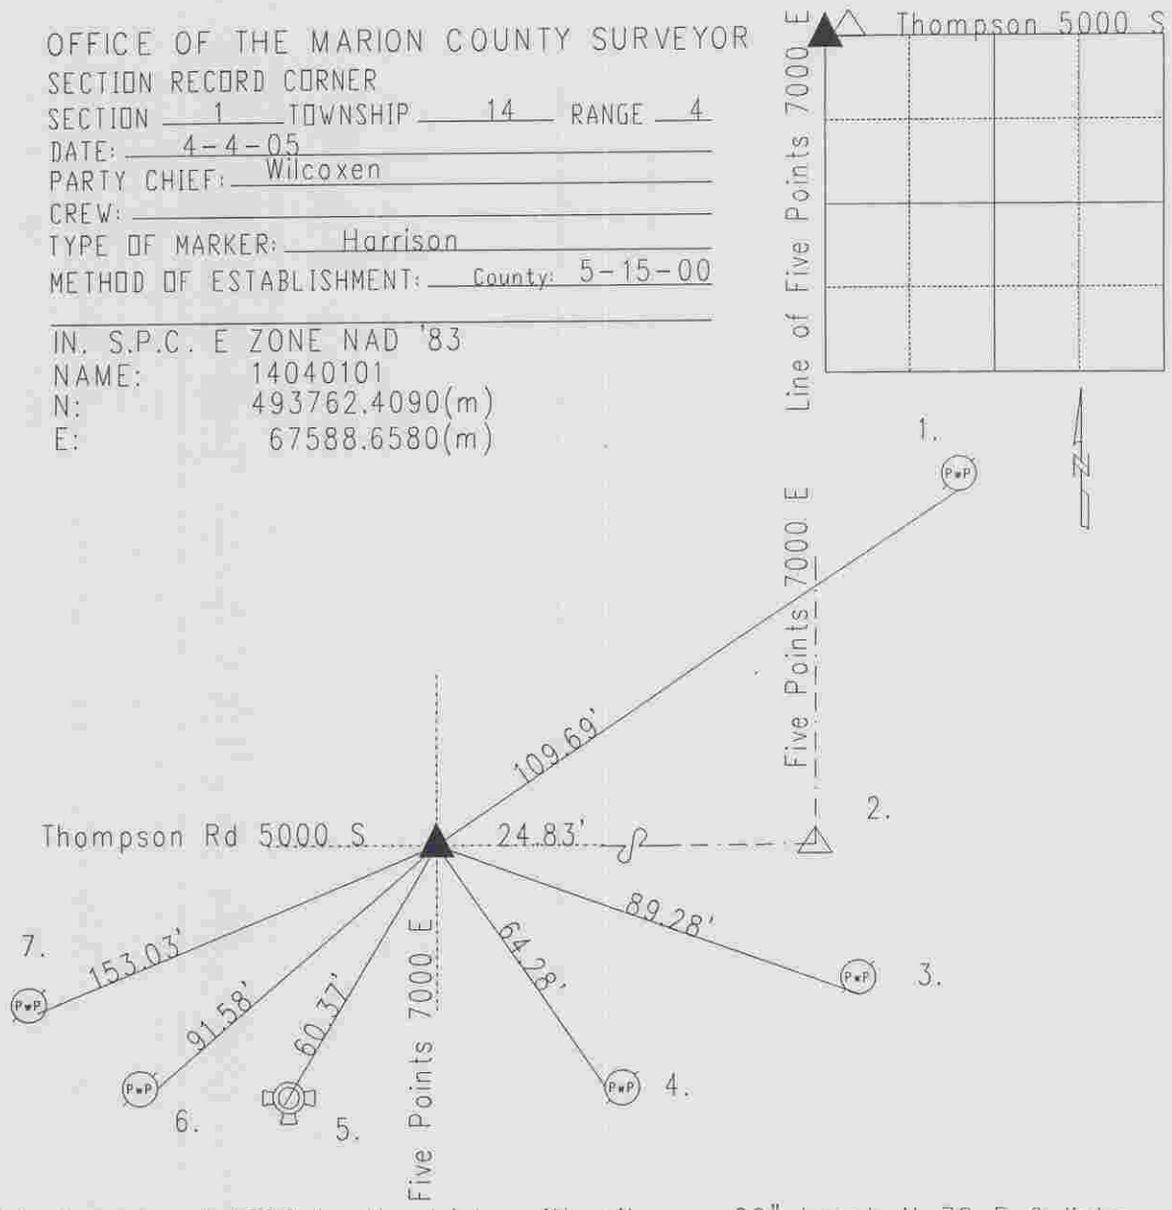

Original post set 1820 by Hendricks with witness: 20" beech N 78 E 9 links, 14" hickory N 23 W 31 links per Marion County Atlas pg. 9. Reference, no date, called stone as monument also called double corner, lying 26' W of common corner between Section 35 & 36. 6-20-52 called double corner. 8-13-63 called 25' between corners. 8-19-70, 8-23-71, and 6-24-75 called the 25', railroad spike at surface. Excavated and set Harrison 7-22-86. Re-tied 10-23-98 by Whiteside. Re-tied 5-15-00 by Wilcoxen. Re-tied 4-5-05 by Wilcoxen.
14040101

REF.	DISTANCE	DESCRIPTION
1.	109.69'	Mag nail w/brass washer S PwP#20-708 24"up
2.	24.83'	Due E to SW corner of 36-15-4 Railroad spike
3.	89.28'	Mag nail w/brass washer S PwP#542-708 12"up
4.	64.28'	PK nail w/washer W PwP#833-1256 3"up
5.	60.37'	Top nut of fire hydrant
6.	91.58'	Mag nail w/brass washer SE PwP#37-707 40"up
7.	153.03'	Mag nail w/brass washer SE PwP#38-707 36"up