OFFICE OF THE MARION COUNTY SURVEYOR
SECTION RECORD CORNER
SECTION 6 TOWNSHIP 14 RANGE 4
DATE: 7-12-03
PARTY CHIEF: Wilcoxen
CREW:
TYPE OF MARKER: 4"x4" conc. sub. marker w/cut'x'
METHOD OF ESTABLISHMENT: County

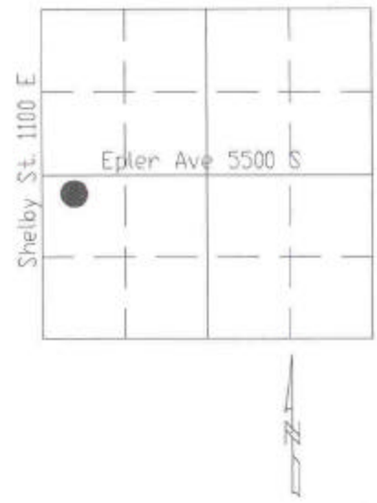

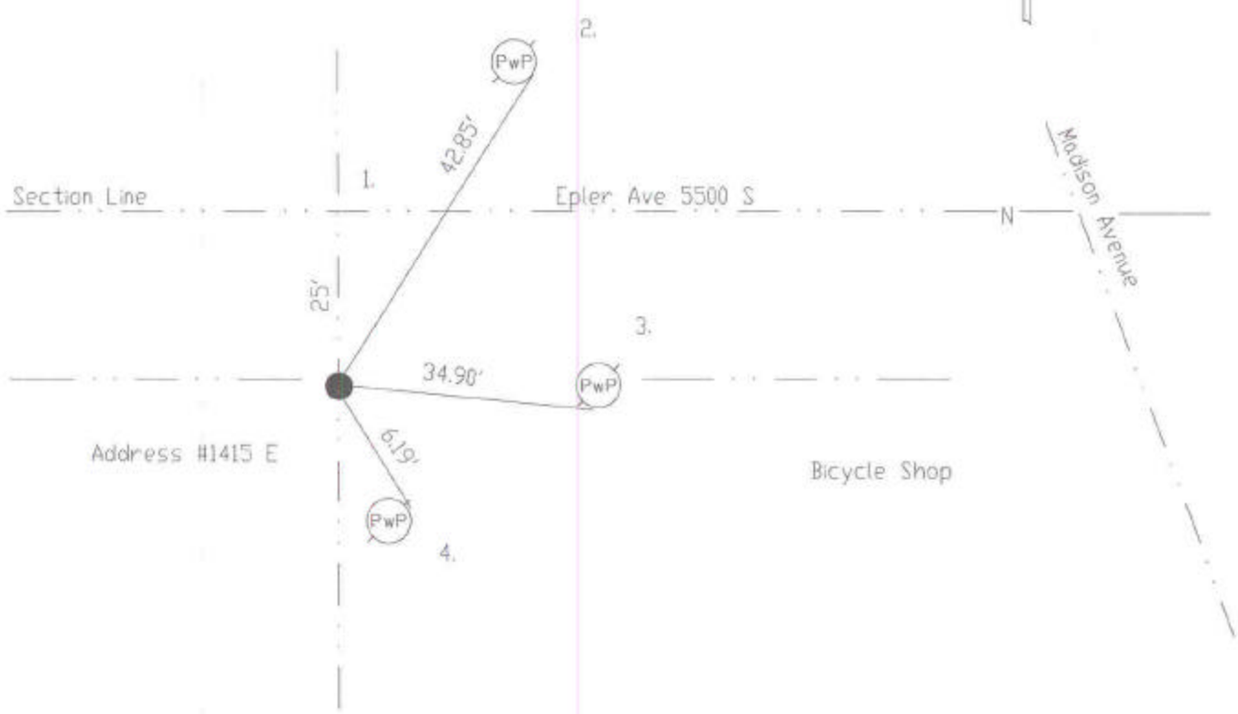

PX4406B

REF.	DISTANCE	DESCRIPTION
1.	25.00'	Due N to section line
2.	42.85'	PK w/MCS brass washer SE PwP#8-698 B
3.	34.90'	PK w/MCS brass washer S PwP#416-728 4"up
4.	6.19'	PK w/MCS brass washer E PwP no# 6"up