OFFICE OF THE MARION COUNTY SURVEYOR
SECTION RECORD CORNER
SECTION 9 TOWNSHIP 14 RANGE 4
DATE: ~~3-19-01~~ 9-29-06
PARTY CHIEF: Whiteside
CREW:
TYPE OF MARKER: Steel Rebar Found
METHOD OF ESTABLISHMENT: County: 4-9-96

IN. S.P.C. E ZONE, NAD 83
NAME: 14040904
N: 491265.6620(m)
E: 62692.1139(m)

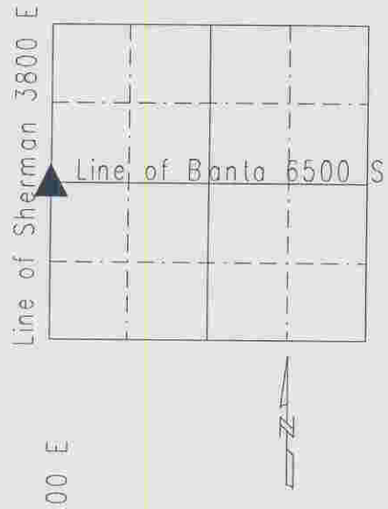

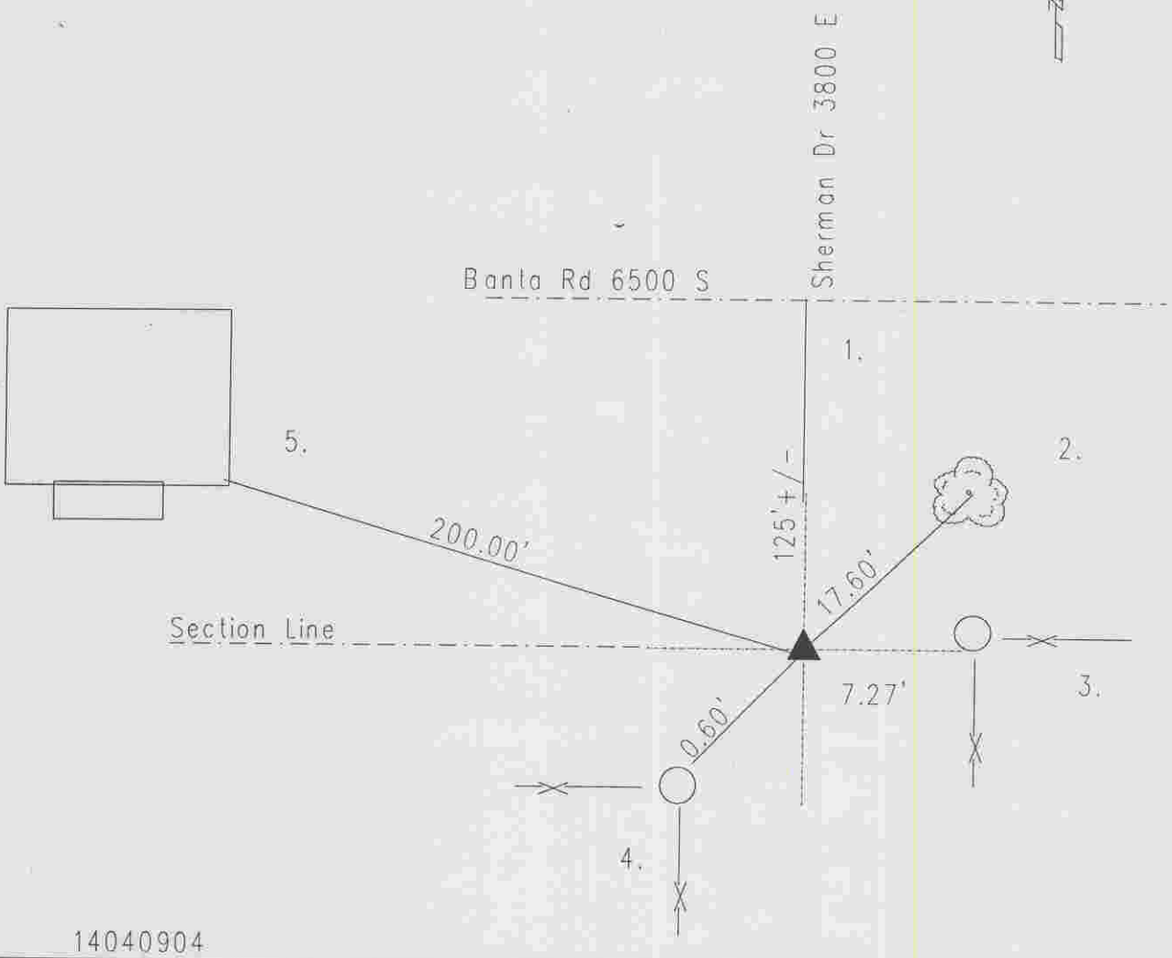

14040904

REF.	DISTANCE	DESCRIPTION
1.	125'+/-	Due N to C/L of Banta Rd 6500 S
2.	17.60'	PK nail E 20" hickory 24"up
3.	7.27'	PK nail S-fence post
4.	0.60'	Rebar S 19" corner fence post
5.	200.00'	SE corner of stone for ADDRESS 3555