OFFICE OF THE MARION COUNTY SURVEYOR
SECTION RECORD CORNER
SECTION 9 TOWNSHIP 14 RANGE 4
DATE: ~~4-24-2000~~ 8-8-07
PARTY CHIEF: Wilcoxen
CREW:
TYPE OF MARKER: Survey marker nail set
METHOD OF ESTABLISHMENT: County: 10-4-94

NOTE: This corner position represents a title corner and may not necessarily be in the position of the Record corner.

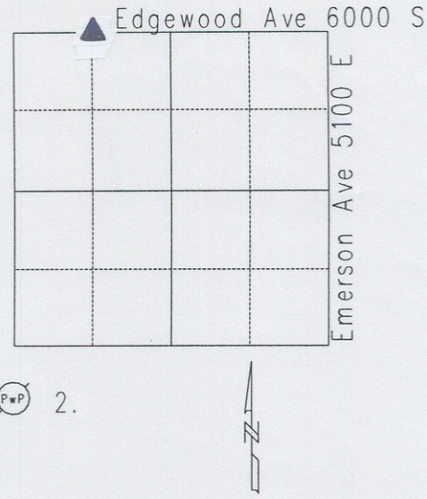

IN.S.P.C. E ZONE'83
Name: 14040910
N: 492095.4117(m)
E: 63103.6120(m)

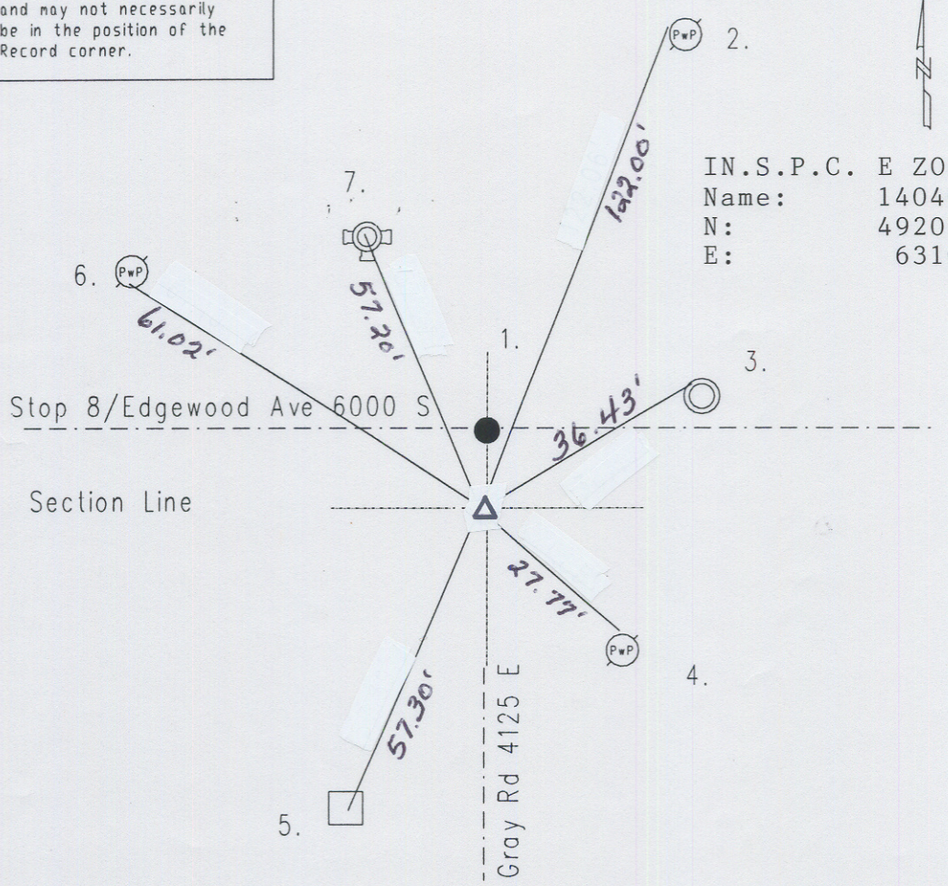

PX440910

REF.	DISTANCE	DESCRIPTION
1.	9.04'	Due N to PK nail set : Record Corner
2.	122.00'	PK nail W PwP#222-732 15"up
3.	36.43'	Cut 'x' N-edge of manhole rim
4.	27.77'	Mag nail w/brass washer N PwP#39-732 10"up
5.	57.30'	Cut 'x' 'center' R/W marker
6.	61.02'	Small PK nail W PwP no# 16"up
7.	57.20'	Top nut of fire hydrant