OFFICE OF THE MARION COUNTY SURVEYOR
SECTION RECORD CORNER
SECTION 12 TOWNSHIP 14 RANGE 4
DATE: 4-8-05
PARTY CHIEF: Wilcoxen
CREW:
TYPE OF MARKER: T-post set ;Harrison destroyed
METHOD OF ESTABLISHMENT: County: 7-29-99

IN. S.P.C. E ZONE NAD '83
NAME: 14041203
N: 492188.0858(m)
E: 69221.4268(m)

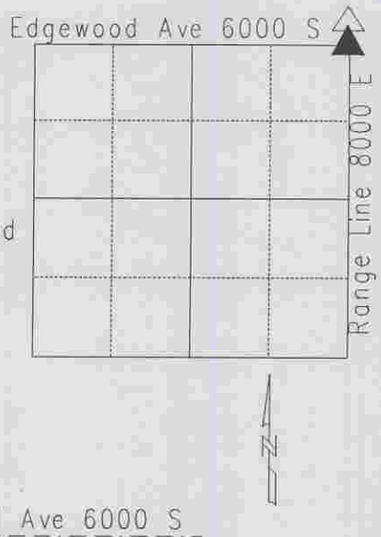

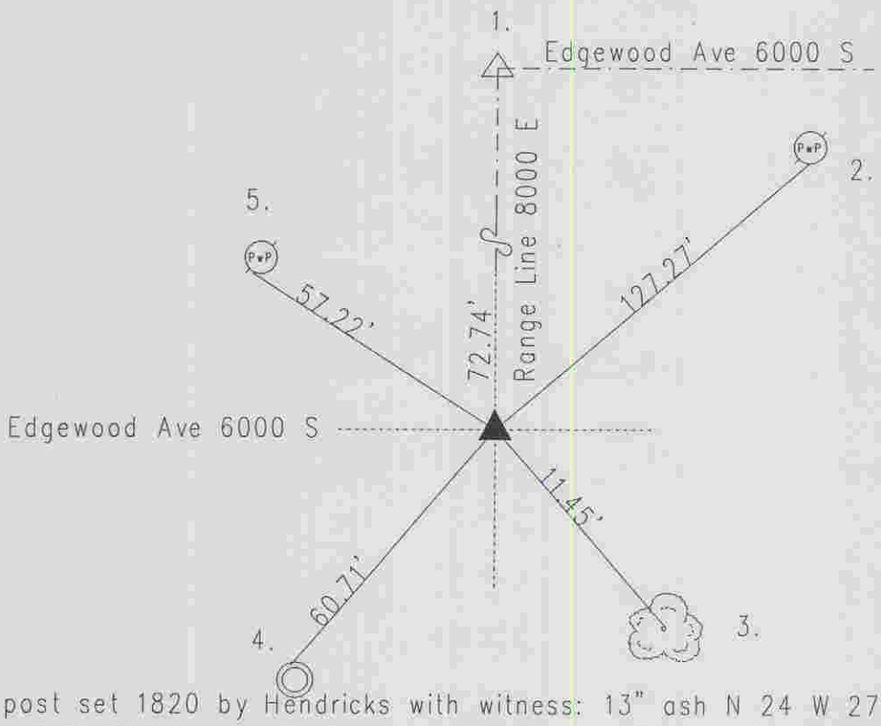

Original post set 1820 by Hendricks with witness: 13" ash N 24 W 27 links; 29" beech S 15 W 18 links per Marion County Atlas pg. 9. No reference to corner per Franklin Township Legal Survey Book. 12-5-69 called stone. 8-17-79 called stone 8" above surface. Excavated 9-10-84 stone at surface. Set Harrison 9-10-87. Re-tied by Kiste 7-29-99. Re-tied 4-8-05 by Wilcoxen, Harrison is destroyed. T-post set.

14041203

REF.	DISTANCE	DESCRIPTION
1.	72.74'	Due N to Harrison NW corner of 7-14-5
2.	127.27'	Mag nail w/brass washer S PwP#833-1401 6"up
3.	11.45'	Mag nail w/brass washer F elm 12"up
4.	60.71'	Cut 'x' W-edge of sewer manhole
5.	57.22'	PK nail SW PwP#833-1400 36"up