OFFICE OF THE MARION COUNTY SURVEYOR
SECTION RECORD CORNER
SECTION 15 TOWNSHIP 14 RANGE 4
DATE: 5-05-05
PARTY CHIEF: Wilcoxen
CREW:
TYPE OF MARKER: Stone found
METHOD OF ESTABLISHMENT: County: 4-25-00

IN. S.P.C. E ZONE NAD '83
NAME: 14041505
N: 489704.8089(m)
E: 65123.6871(m)

NOTE: This corner position represents a title corner and may not necessarily be in the position of the Record corner.

Note: stone found by
P.I. Cripe Job#87107-30460

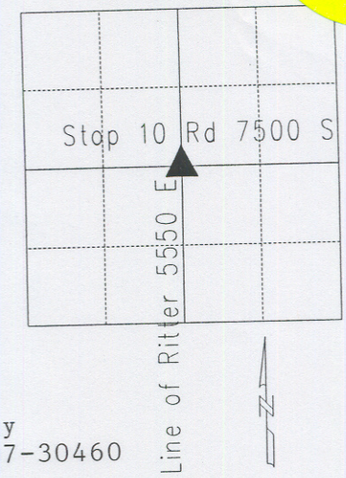

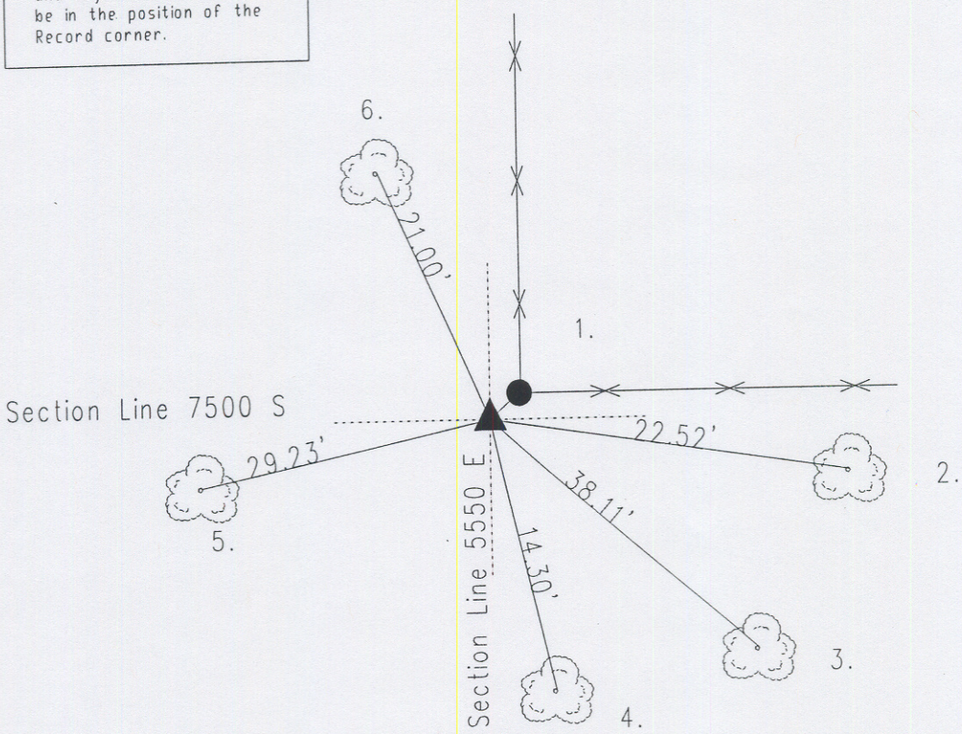

14041505

REF.	DISTANCE	DESCRIPTION
1.	0.2'	Northeasterly to corner of 6' wooden privacy fence
2.	22.52'	Mag nail w/brass washer N 12" walnut 6"up
3.	38.11'	Mag nail w/brass washer SW 6" hickory 24"up
4.	14.30'	PK nail w/brass washer F 6" hackberry 24"up
5.	29.23'	Mag nail w/brass washer S 10" hickory 15"up
6.	21.00'	PK nail F Twin ash 24"up