OFFICE OF THE MARION COUNTY SURVEYOR
SECTION RECORD CORNER
SECTION 20 TOWNSHIP 14 RANGE 4
DATE: ~~6-2-92~~ ~~5-23-2000~~ 5-06-05
PARTY CHIEF: Wilcoxen
CREW:
TYPE OF MARKER: Rebar Fd per ties
METHOD OF ESTABLISHMENT: County

IN. S.P.C. E ZONE, NAD 83
NAME: 14042004
N: 487967.1046(m)
E: 61045.2149(m)

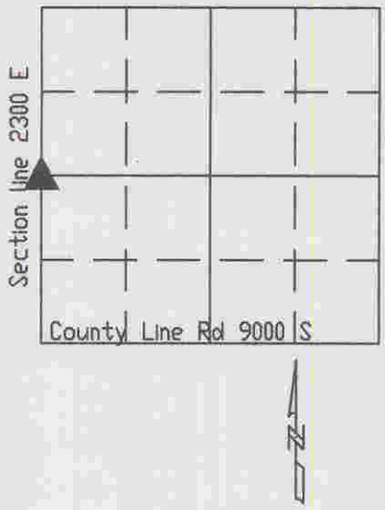

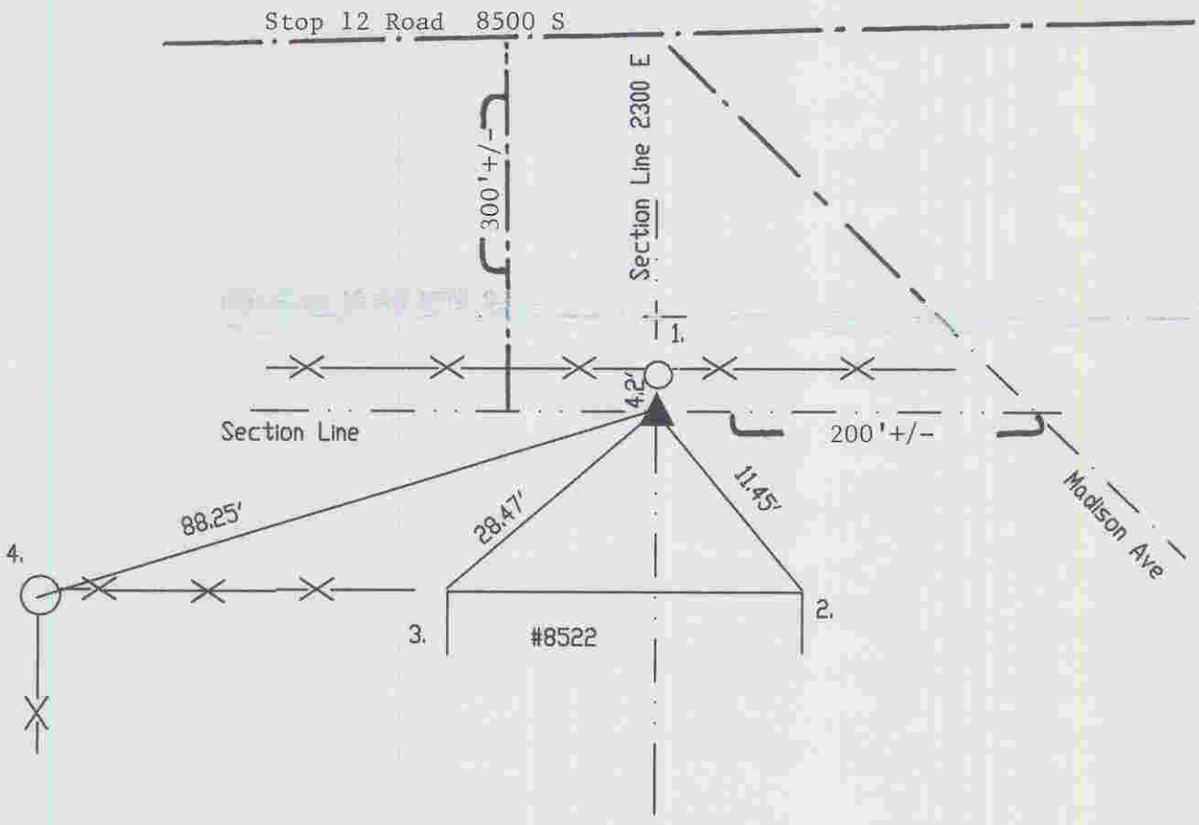

SC442004

REF.	DISTANCE	DESCRIPTION
1.	4.2'	Due N to fence line
2.	11.45'	NE #8522 Madison Ave
3.	28.47'	NW "
4.	88.25'	Center of corner steel fence post