OFFICE OF THE MARION COUNTY SURVEYOR
SECTION RECORD CORNER
SECTION 21 TOWNSHIP 14 RANGE 4
DATE: 2-29-08
PARTY CHIEF: Wilcoxen
CREW:
TYPE OF MARKER: Railroad spike at surface over stone
METHOD OF ESTABLISHMENT: County: 4-17-95

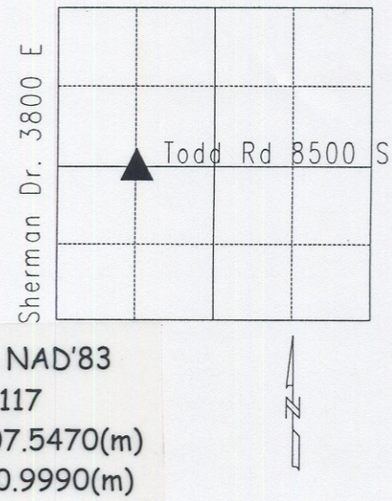

NOTE: This corner position represents a title corner and may not necessarily be in the position of the Record corner.

IN. S.P.C. E ZONE, NAD'83
Name: 14042117
N: 488007.5470(m)
E: 63080.9990(m)

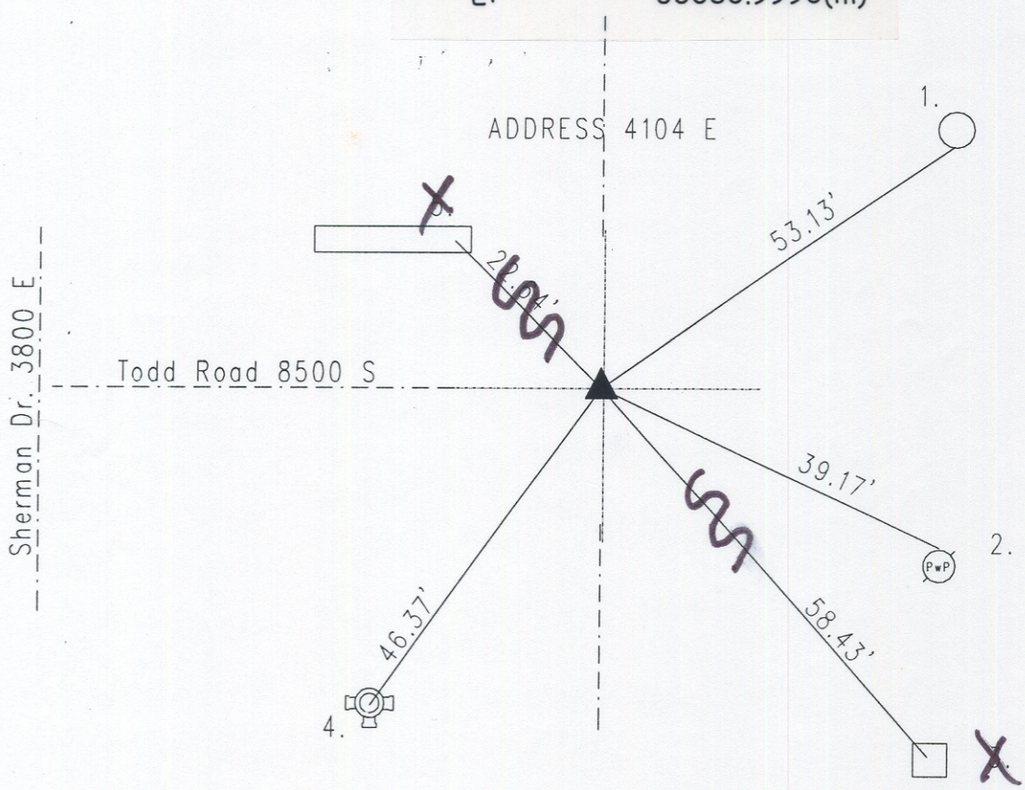

SX442117

REF.	DISTANCE	DESCRIPTION
1.	53.13'	PK nail S light pole #154-792 10"up
2.	39.17'	PK nail N PwP#24-822 12"up
~~3.~~	~~58.43'~~	~~Cut 'x' SW concrete base of sewer pit~~
4.	46.37'	Top nut of fire hydrant
~~5.~~	~~22.64'~~	~~Cut 'x' E end of sidewalk~~