OFFICE OF THE MARION COUNTY SURVEYOR
SECTION RECORD CORNER
SECTION 23 TOWNSHIP 14 RANGE 4
DATE: ~~7-02-01~~-- 9-8-06
PARTY CHIEF: ~~Wilcoxen~~--Kiste
CREW:
TYPE OF MARKER: NOTE:
METHOD OF ESTABLISHMENT: County: 9-28-94

NOTE: Survey marker nail set over 1 1/2" lead pipe by stone down 10".

IN. S.P.C. E ZONE NAD 83
NAME: 14042314
N: 488513.0890(m)
E: 66748.3830(m)

THIS CORNER POSITION REPRESENTS A "TITLE" CORNER AND MAY NOT NECESSARILY REPRESENT THE POSITION BASED ON RECORD CORNERS.

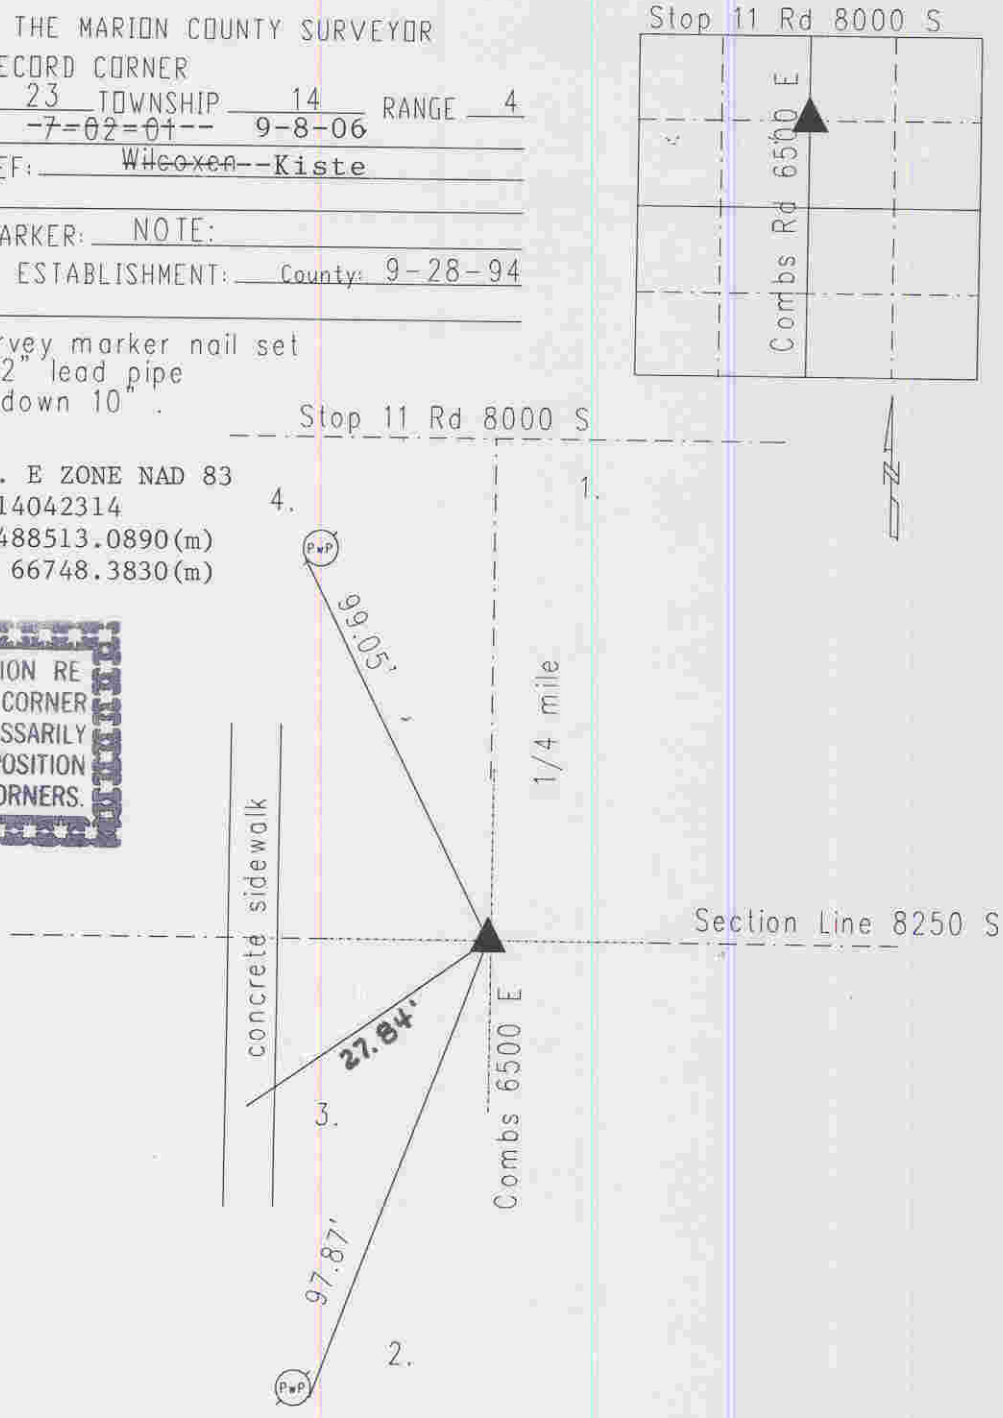

SX442314

REF.	DISTANCE	DESCRIPTION
1.	1/4 mi	Due N to Stop Rd 8000 S Harrison marker
2.	97.87'	Mag nail w/brass washer SE PwP#612-796 15"up
3.	27.84'	Mag nail w/brass washer in joint of sidewalk
4.	99.05'	Mag nail w/brass washer SW PwP#611-796 15"up