OFFICE OF THE MARION COUNTY SURVEYOR
SECTION RECORD CORNER
SECTION 24 TOWNSHIP 14 RANGE 4
DATE: ~~6-1-00~~ 3-7-05
PARTY CHIEF: Wilcoxen
CREW:
TYPE OF MARKER: Harrison
METHOD OF ESTABLISHMENT: County: 1-18-95

IN. S.P.C. E ZONE, NAD 83
NAME: 14042402
N: 488937.8366(m)
E: 68392.0086(m)

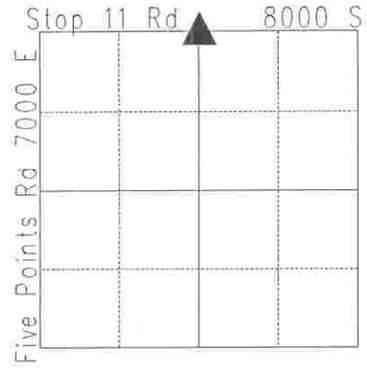

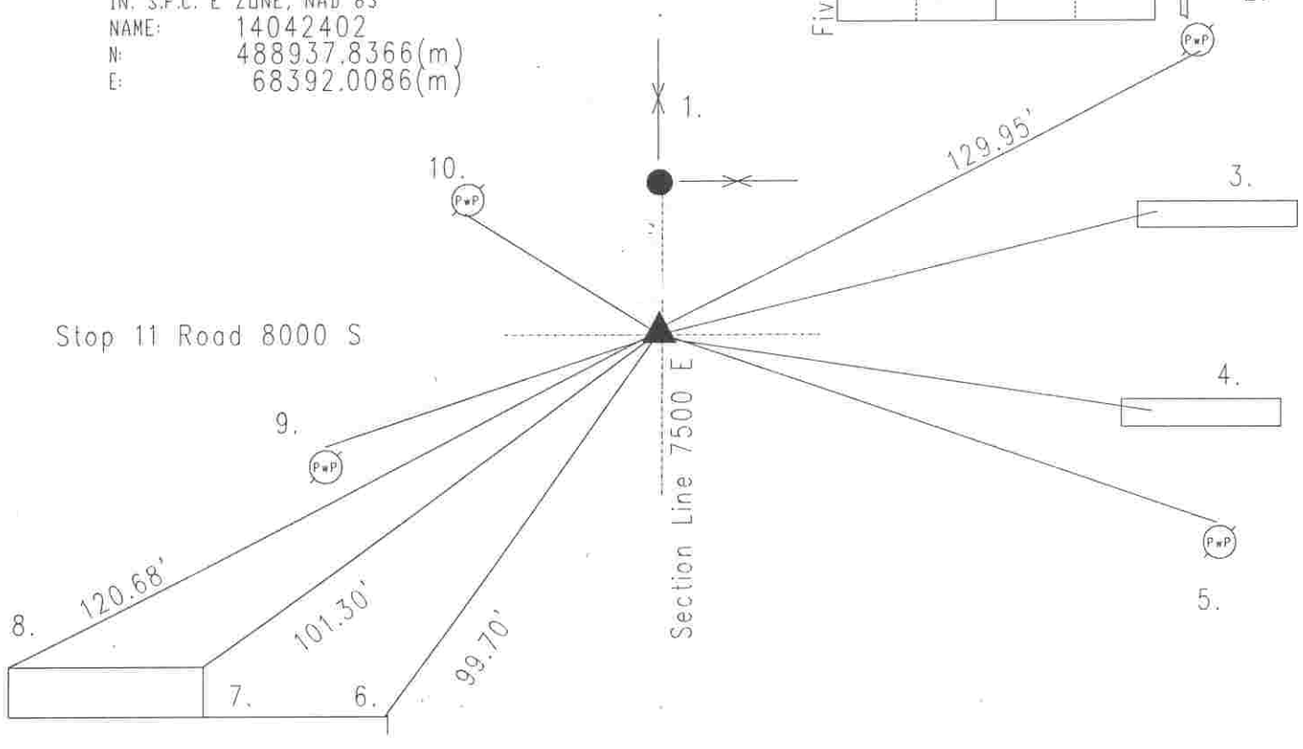

Original post set 1820 by Hendricks with witnesses: 9" ash S 6 E 13 links, 8" white oak N 78 E 8 links per M.C. Atlas pg. 9. Hosbrook 2-10-1852 indicates no stone but 20" oak N 85 E 26 links, 8" beech N 71 W 16 links per Franklin Legal Book pg. 23. GWS 2-15-64 called fd nail w/a 2" iron pipe set. McLand 3-26-69 called same. MCS 4-16-70 called 2" iron pipe over stone. Wilcoxen 7-18-75 called same. Wilcoxen 9-20-79 called same. Greene 6-26-86 called same. Whiteside 1-18-95 called railroad spike w/cut 'x'. Kiste 3-31-00 called the same. Excavated by Wilcoxen 6-1-00 and railroad spike fd 3" down. No stone or other monuments were found during excavation. Harrison set.

HC 442402

REF.	DISTANCE	DESCRIPTION
1.	25.59'	Due N to center of steel fence post 15"up
2.	129.95'	PK nail S PwP#73-799 36"up
3.	106.29'	Cut 'x' W-end of conrete headwall
4.	106.24'	Cut 'x' W-end of conrete headwall
5.	138.67'	PK nail N PwP#68-799 36"up
6.	99.70'	NE corner of ADDRESS 7447
7.	101.30'	NE corner "
8.	120.68'	NW corner "
9.	49.78'	Road nail N pwP#55-799 15"up
10.	23.52'	Road nail SW PwP#74-799 15"up