OFFICE OF THE MARION COUNTY SURVEYOR
SECTION RECORD CORNER
SECTION 24 TOWNSHIP 14 RANGE 4
DATE: ~~7-27-99~~ 9-21-04
PARTY CHIEF: ~~Kiste~~ Wilcoxen
CREW: @ surface over stone
TYPE OF MARKER: Fd. Railroad spike
METHOD OF ESTABLISHMENT: County: 9-28-94

IN. S.P.C E ZONE, NAD 83
NAME: 14042425
N: 487315.6973(m)
E: 68786.8779(m)

NOTE: This corner position represents a title corner and may not necessarily be in the position of the Record corner.

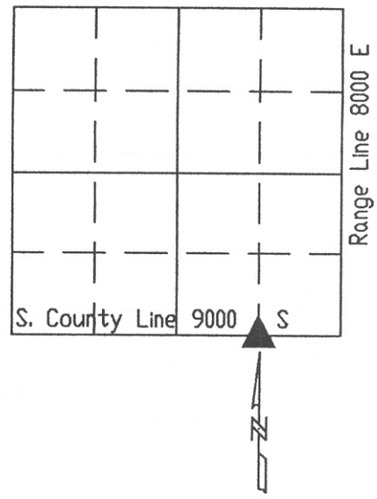

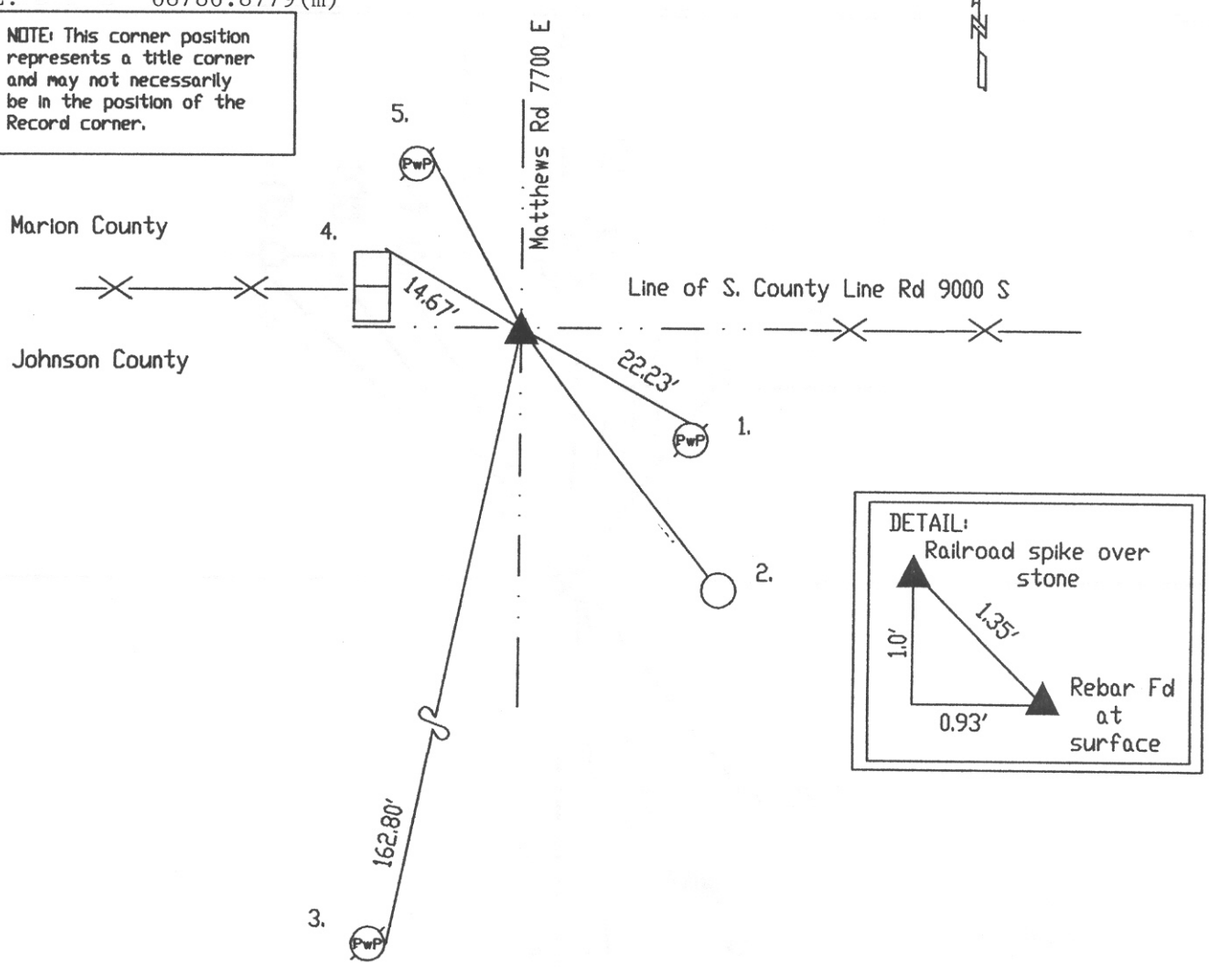

SX442425

REF.	DISTANCE	DESCRIPTION
1.	22.23'	Fd PK nail N PwP#57-829 12"up
2.	39.64'	PK nail w/Johnson Co. washer W PwP 15"up
3.	162.80'	PK nail E PwP#41-829 6"up
4.	14.67'	Fd. PK nail N fence post
5.	14.32'	PK nail NE PwP#1-829 6"up