OFFICE OF THE MARION COUNTY SURVEYOR
SECTION RECORD CORNER
SECTION 4 TOWNSHIP 14 RANGE 5
DATE: 1-18-99
PARTY CHIEF: Kiste
CREW:
TYPE OF MARKER: Harrison
METHOD OF ESTABLISHMENT: County

IN. S.P.C. E ZONE, NAD 83
NAME: 14050404
N: 493106.3486(m)
E: 72298.0713(m)

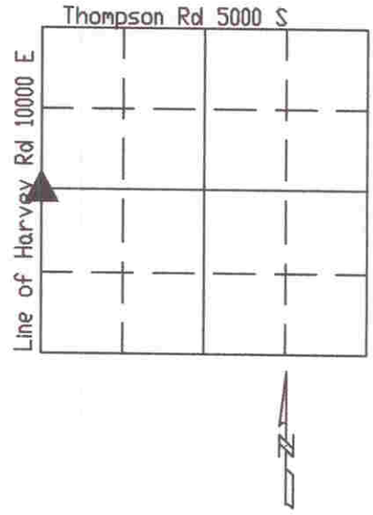

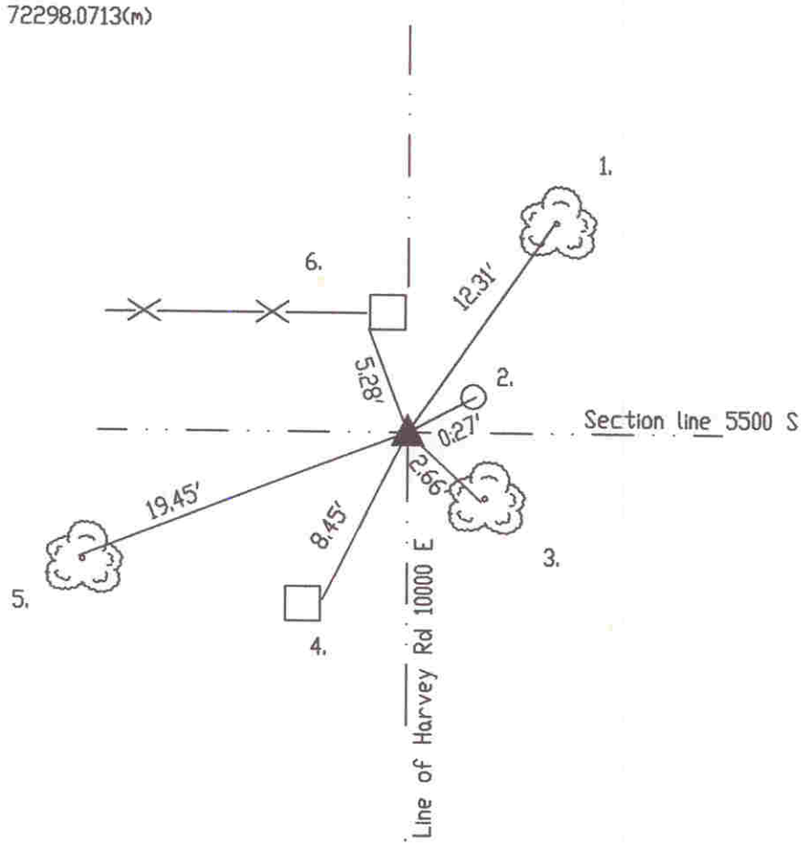

Original post set 1820 by John Hendricks with witnesses: 12" beech S 18 W 29 links, 4" beech N 19 W 14 links per Marion County Atlas pg. 13. There is no reference to this corner per the Franklin Township Legal Survey Book. 10-4-77 called for stone. This corner excavated 7-12-88 stone found at surface and Harrison set. Re-tied 1-19-99 by Kiste.

HC450404

REF.	DISTANCE	DESCRIPTION
1.	12.31'	Boat spike W 36" maple w/spur root
2.	0.27'	3/4" iron pipe
3.	2.66'	Boat spike W 10" hickory 2" up
4.	8.45'	Road nail E wooden fence post
5.	19.45'	Boat spike N 12" hickory 18"up
6.	5.28'	Road nail SW corner wooden fence post