OFFICE OF THE MARION COUNTY SURVEYOR
SECTION RECORD CORNER
SECTION 8 TOWNSHIP 14 RANGE 5
DATE: ~~10-15-02~~ 1-11-07
PARTY CHIEF: Wilcoxen
CREW:
TYPE OF MARKER: Survey mark nail FD
METHOD OF ESTABLISHMENT: County: 7-22-98

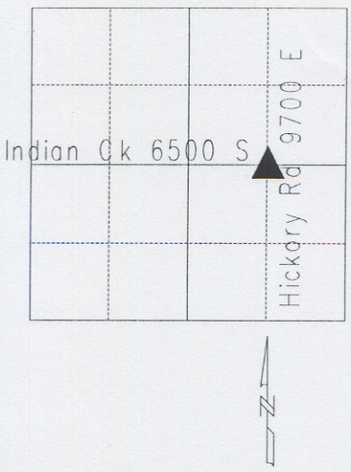

NOTE: This corner position represents a title corner and may not necessarily be in the position of the Record corner.

IN. S.P.C. E ZONE, NAD'83
Name: 14050818
N: 491455.0220(m)
E: 71858.2910(m)

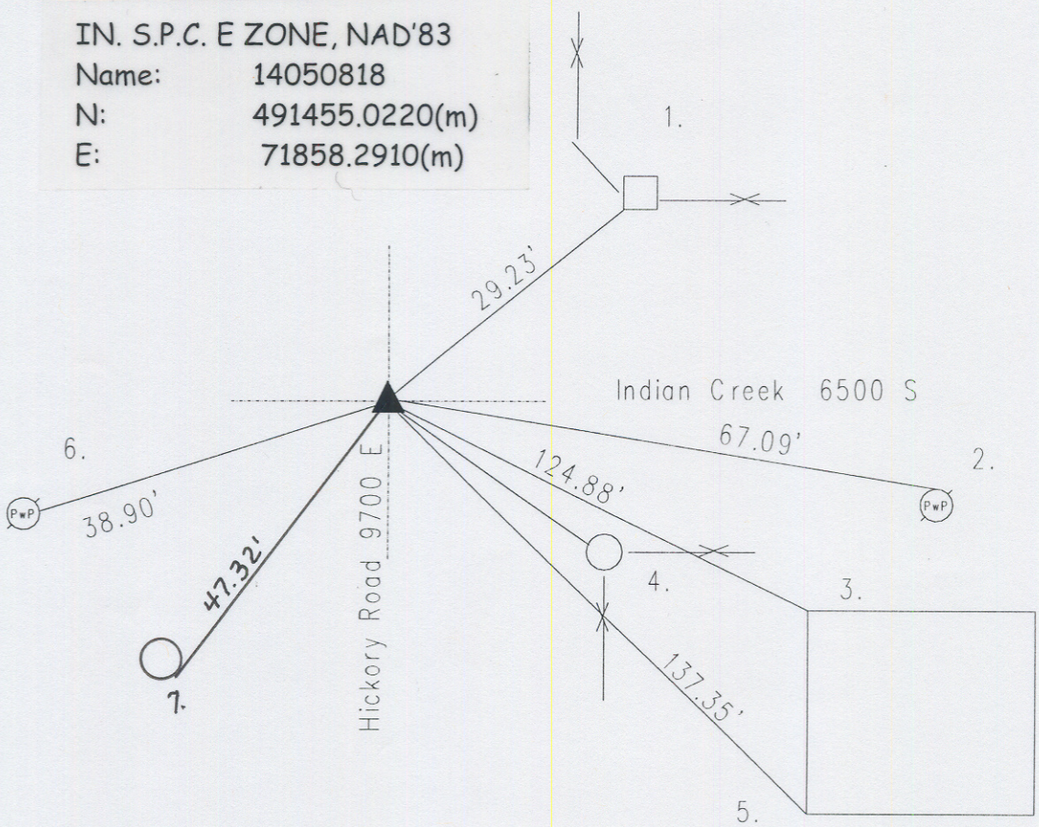

SX450818

REF.	DISTANCE	DESCRIPTION
1.	29.23'	Road nail SW wooden fence post
2.	67.09'	PK nail w/shiner N PwP#18-771 BA 24"up
3.	124.88'	NE corner of wood & stone home ADDRESS 6505
4.	~~31.18'~~	~~Top 'c' corner fence post~~
5.	137.35'	SW corner of wood & stone home ADDRESS 6505
6.	38.90'	PK nail E PwP#8-771 BA 24"up
7.	47.32'	Mag nail w/bw E PwP no# 20"up