OFFICE OF THE MARIÓN COUNTY SURVEYOR
SECTION RECORD CORNER
SECTION 16 TOWNSHIP 14 RANGE 5
DATE: 8-14-07
PARTY CHIEF: Wilcoxen
CREW:
TYPE OF MARKER: Harrison
METHOD OF ESTABLISHMENT: County: 2-25-02

IN. S.P.C. E ZONE NAD '83
NAME: 14051601
N: 490652.5788(m)
E: 72249.4803(m)

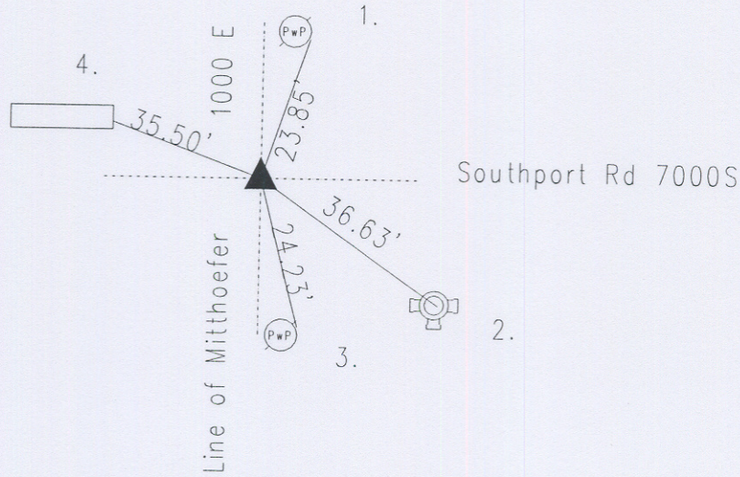

Original post set 1820 by hendricks with witness: 12" ash S 8 E 14 links; 12" dogwood N 64 W 9 links per Marion County Atlas pg. 13. Hosbrook 12-15-1853 called no stone but witness: 4" walnut N 10 E 33 1/2 links; 6" walnut E 25 links per Franklin Township Legal Survey Book pg.39. Monroe 11-25-59 called pipe over stone. Schmidt 9-18-61 called the same. Fortner 10-28-74 called PK nail. MCSO 7-18-85 called same. Marendt 10-29-89 called the same. Kiste excavated 9-15-94 PK nail w/washer found at surface. Wooden hub fd 13" down. Stone found 26" down. Set Harrison. Re-tied 7-7-97 by Kiste. Re-tied 2-25-02 by Wilcoxen. Re-tied 8-14-07 by Wilcoxen.

REF.	DISTANCE	DESCRIPTION
1.	23.85'	PK nail F guide pole #95-771 B 24"up
2.	36.63'	Top nut of fire hydrant
3.	24.23'	Mag nail w/bw F PwP#94-771BB 15"up
4.	35.50'	Cut 'x' in headwall