OFFICE OF THE MARION COUNTY SURVEYOR

SECTION RECORD CORNER

SECTION 17 TOWNSHIP 14 RANGE 5

DATE: ~~4-26-00~~ 1-06-05

PARTY CHIEF: Wilcoxen

CREW:

TYPE OF MARKER: Stone found w/cut 'x' 8" dn

METHOD OF ESTABLISHMENT: County: 1-13-95

IN. S.P.C. E ZONE, NAD 83

NAME: 14051705

N: 489805.9090(m)

E: 71432.3464(m)

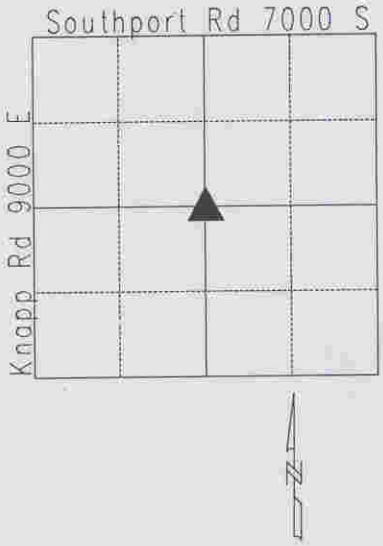

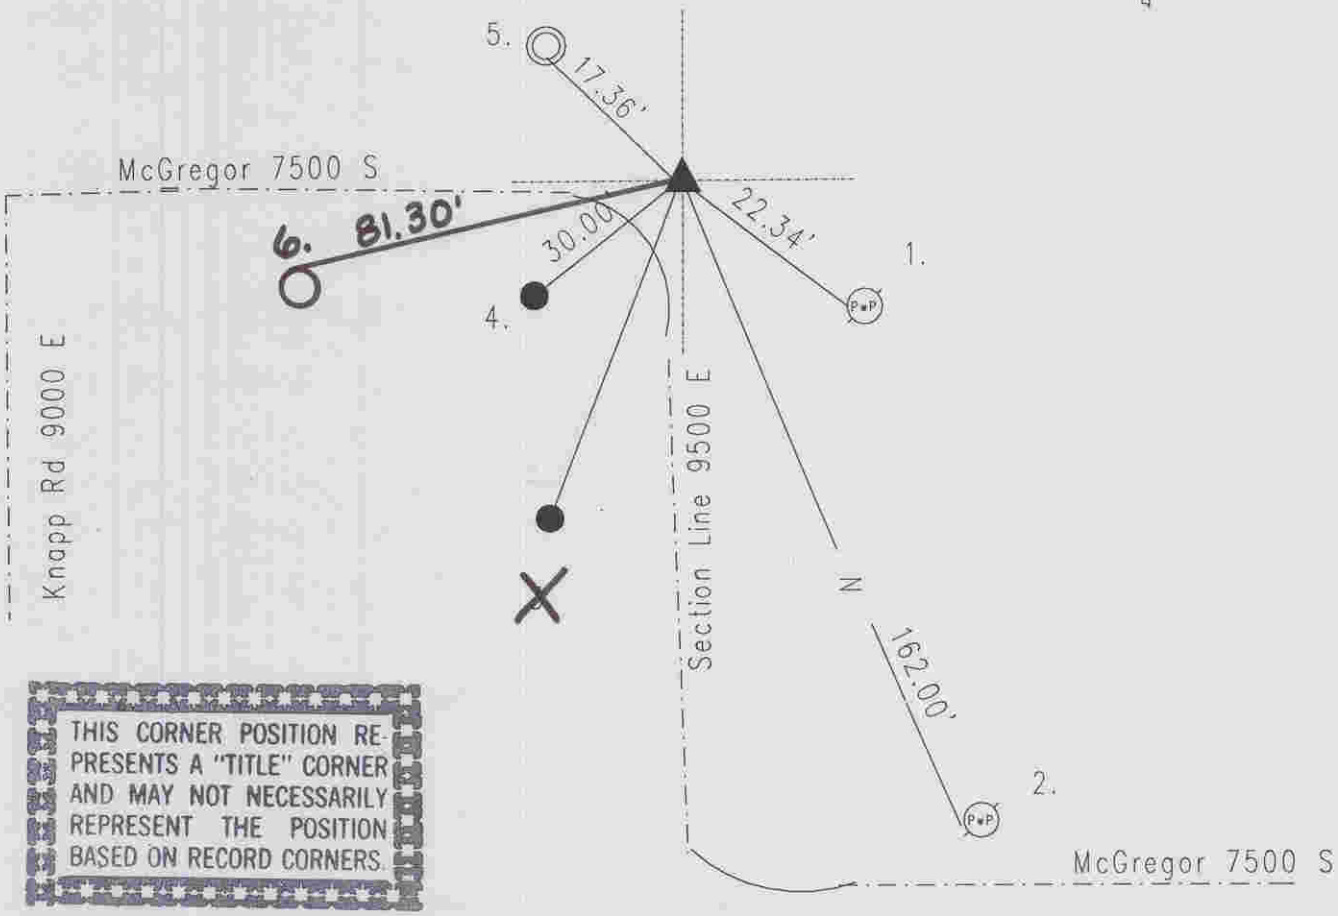

THIS CORNER POSITION REPRESENTS A "TITLE" CORNER AND MAY NOT NECESSARILY REPRESENT THE POSITION BASED ON RECORD CORNERS.

SC 451705

REF.	DISTANCE	DESCRIPTION
1.	22.34'	Mag nail w/brass washer W PwP#70-801B 12"up
2.	162.00'	PK nail W PwP#69-801B
3.	~~43.93'~~	~~1" pipe found~~
4.	30.00'	1 1/4" steel pin fd 8" down
5.	17.36'	Cut 'x' S-edge sewer manhole
6.	81.30'	Mag nail w/bw N PwP no# 15"up