OFFICE OF THE MARION COUNTY SURVEYOR
SECTION RECORD CORNER
SECTION 21 TOWNSHIP 14 RANGE 5
DATE: ~~10-15-02~~ 1-11-07
PARTY CHIEF: Wilcoxen
CREW:
TYPE OF MARKER: Railroad spike FD
METHOD OF ESTABLISHMENT: County: 10-26-98

IN. S.P.C. E ZONE NAD '83
NAME: 14052107
N: 487372.9011(m)
E: 72229.3490(m)

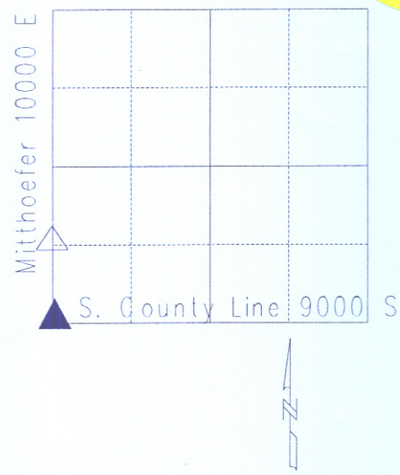

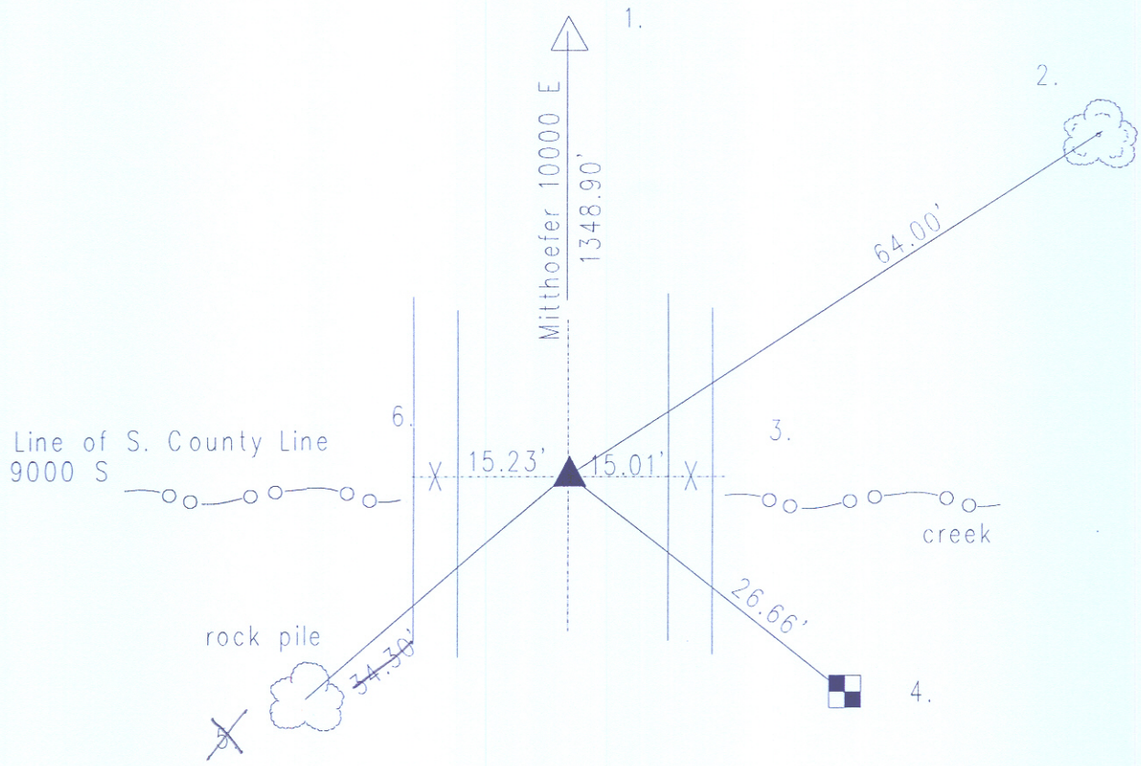

14052107

REF.	DISTANCE	DESCRIPTION
1.	1348.90'	Due N to QQ corner (Pipe over stone found)
2.	64.00'	Boat spike top of ash tree stump
3.	15.01'	Due E to cut 'x' in bolt
4.	26.66'	'c' copperweld in concrete stamped : JOHNSON COUNTY SURVEY MARKER
5.	~~34.30'~~	~~Rebar E of rock pile~~
6.	15.23'	Due W to cut 'x' in bolt