c

OFFICE OF THE MARION COUNTY SURVEYOR
SECTION RECORD CORNER
SECTION 13 TOWNSHIP 15 RANGE 2
DATE: ~~1-17-95~~ 5-3-2000
PARTY CHIEF: Whiteside
CREW:
TYPE OF MARKER: 1 1/2" iron pipe
METHOD OF ESTABLISHMENT: County: 11-6-85

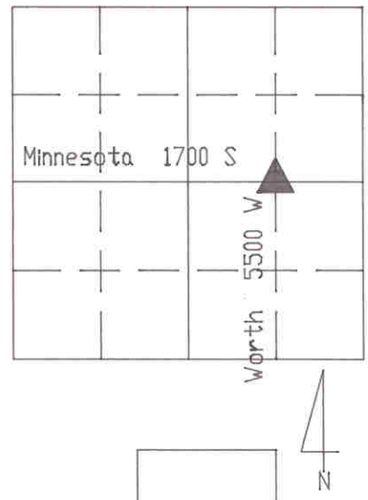

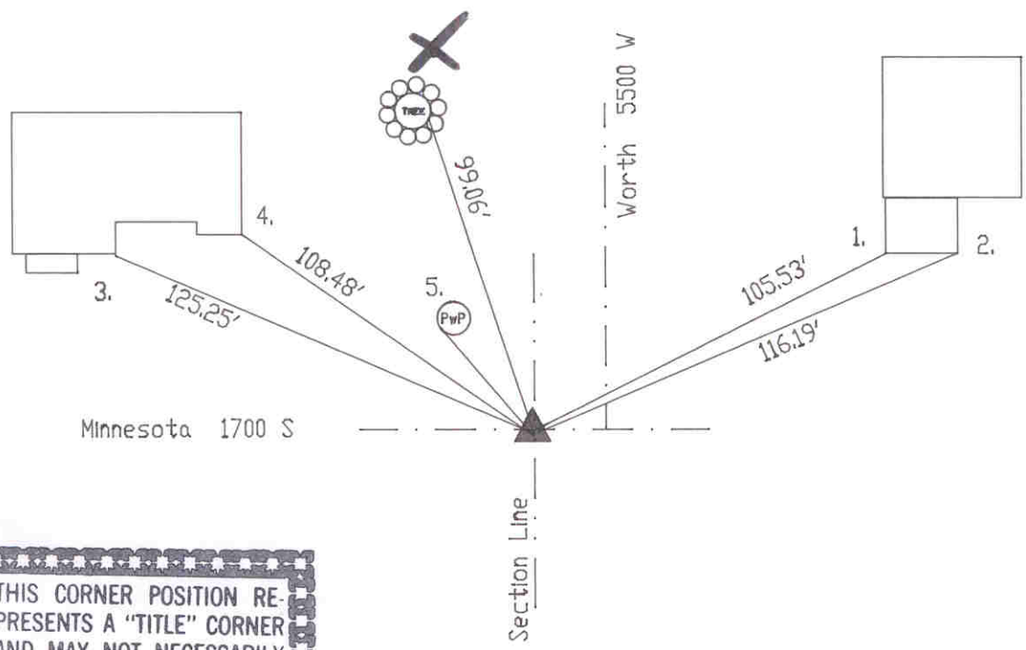

THIS CORNER POSITION REPRESENTS A "TITLE" CORNER AND MAY NOT NECESSARILY REPRESENT THE POSITION BASED ON RECORD CORNERS.

SX521318

REF.	DISTANCE	DESCRIPTION
1.	105.53'	SW porch #5620
2.	116.19'	SE "
3.	125.25'	Southerly #5636
4.	108.48'	SE "
5.	24.85'	PK W PwP#65-35558
6.	99.06'	Rd E 40" oak 24"up DESTROYED