OFFICE OF THE MARION COUNTY SURVEYOR
SECTION RECORD CORNER
SECTION 14 TOWNSHIP 15 RANGE 2
DATE: 8-24-07
PARTY CHIEF: Wilcoxen
CREW:
TYPE OF MARKER: Survey mark nail set
METHOD OF ESTABLISHMENT: County: 4-21-01

NOTE: This corner position represents a title corner and may not necessarily be in the position of the Record corner.

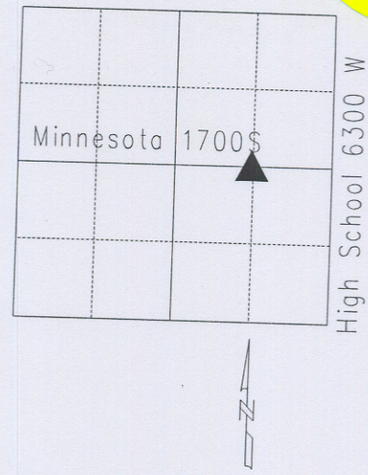


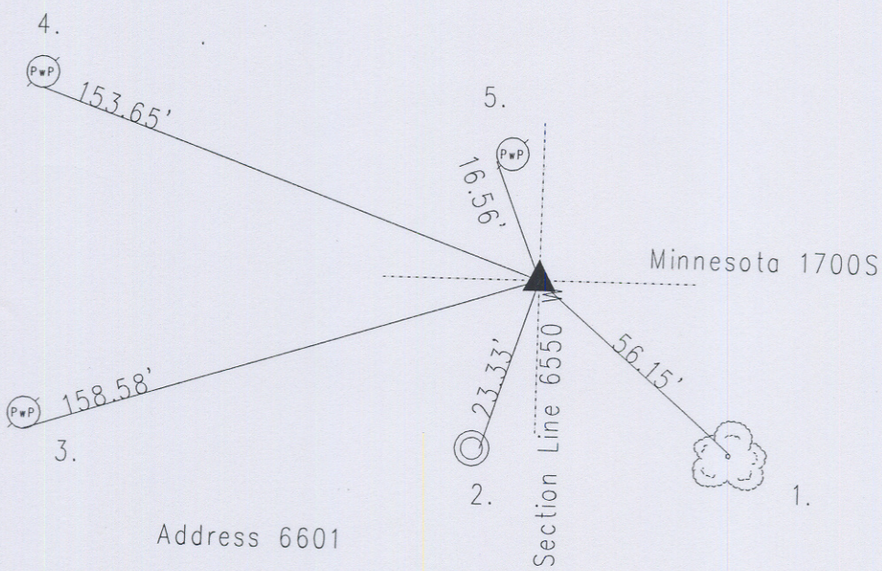


15021418

| REF. | DISTANCE | DESCRIPTION |
|---|---|---|
| 1. | 56.15' | Boat spike spur root 20" silver maple |
| 2. | 23.33' | Cut 'x' in F-rim of sewer manhole |
| 3. | 158.58' | PK nail S PwP#65-593A 12"up |
| 4. | 153.65' | PK nail S PwP#84-553 B 12"up |
| 5. | 16.56' | Large road nail SW PwP#85-553 8"up |