OFFICE OF THE MARION COUNTY SURVEYOR
SECTION RECORD CORNER
SECTION 25 TOWNSHIP 15 RANGE 2
DATE: ~~7-26-99~~ 6-29-04
PARTY CHIEF: Kiste
CREW:
TYPE OF MARKER: Harrison
METHOD OF ESTABLISHMENT: County: 7-21-94

IN. S.P.C. E ZONE, NAD 83
NAME: 15022503
N: 496718.2692(m)
E: 49956.9473(m)

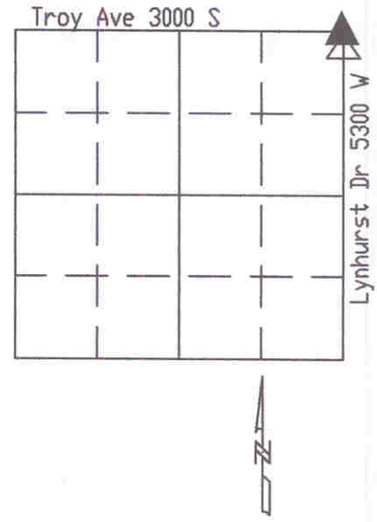

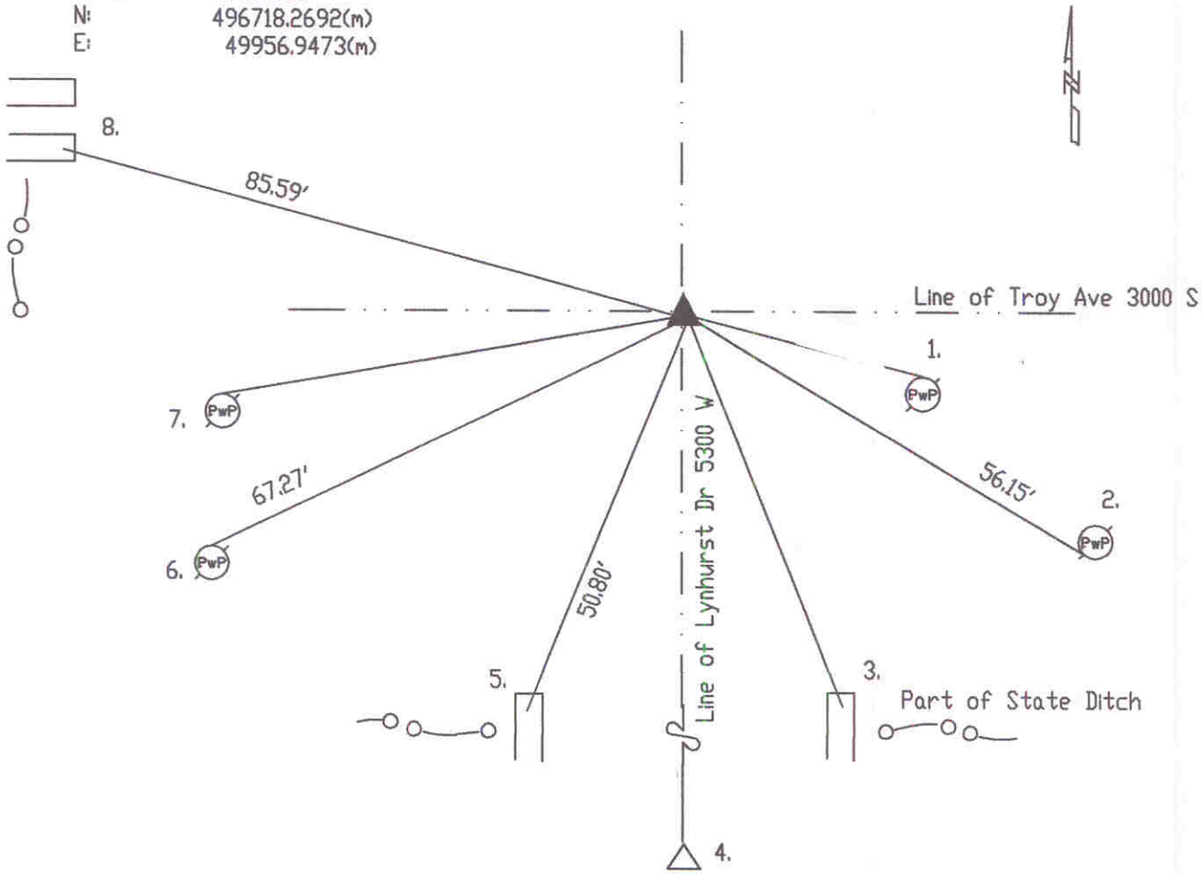

Original post set 1820 by Laughlin with witnesses: 10" sugar S 29 E 30 links, 10" dogwood W 30 N 13 links per Marion County Atlas pg. 2. No record of monument nor witnesses in Legal Book. Miller 2-11-75 called railroad spike. Wilcoxen 4-8-85 called the same. Excavated 7-21-94 by Wilcoxen and MCS railroad spike found 4" down. Harrison set per construction project. Re-tied 7-26-99 by Kiste.

HC522503

REF.	DISTANCE	DESCRIPTION
1.	29.58'	PK nail N PwP#24-626 6"up
2.	56.15'	PK nail SW PwP#124-626 6"up
3.	51.27'	Cut 'x' NE corner of bridge deck over creek
4.	118.28'	Due S to NW corner of Sec. 30-15-3 (Pk nail)
5.	50.80'	Cut 'x' NW corner of bridge deck over creek
6.	67.27'	Mag nail w/MCS brass washer N PwP#180-625 36"up
7.	54.84'	Mag nail w/MCS brass washer N PwP#181-625 36"up
8.	85.59'	Cut 'x' E-end of southerly concrete headwall