OFFICE OF THE MARION COUNTY SURVEYOR
SECTION RECORD CORNER
SECTION 33 TOWNSHIP 15 RANGE 2
DATE: ~~5-28-99~~ ~~4-27-2000~~ 2-23-05
PARTY CHIEF: Kiste
CREW:
TYPE OF MARKER: Note:
METHOD OF ESTABLISHMENT: County: 10-5-94

IN. S.P.C. E ZONE, NAD 83
NAME: 15023304
N: 494171.3247(m)
E: 43431.8322(m)

NOTE: Airport Authority monument in steel box.

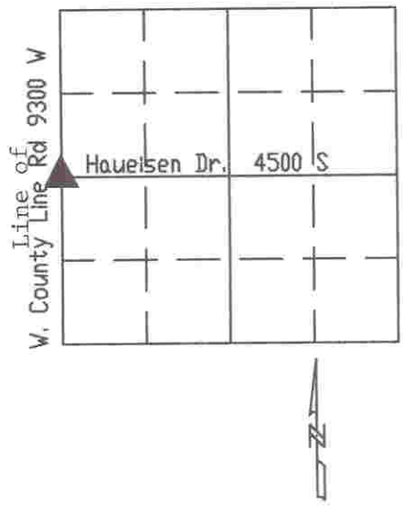

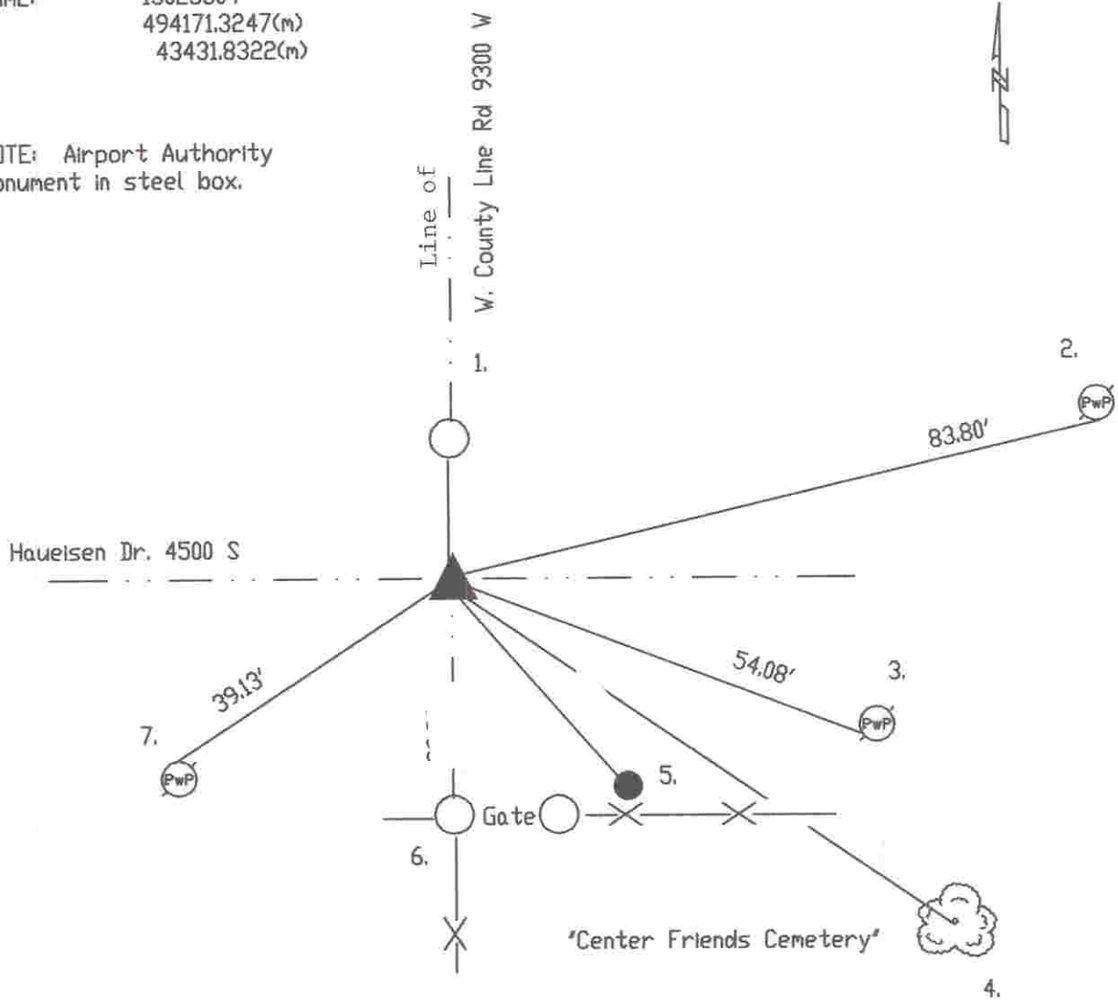

SC523304

REF.	DISTANCE	DESCRIPTION
1.	~~15.85'~~	~~Due N to S face of steel fence post 6" up~~
2.	83.80'	PK nail SE PwP no# 48"up
3.	54.08'	PK nail SW PwP#39-681W 4"up
4.	~~51.61'~~	~~Railroad spike SW spur root for 36" triple maple~~
5.	~~36.68'~~	~~Steel pin in 4"x4" concrete post~~
6.	~~29.39'~~	~~Due S to (W center face steel chain link post)~~
7.	39.13'	PK nail N PwP#1-9681VA 4"up