OFFICE OF THE MARION COUNTY SURVEYOR
SECTION RECORD CORNER
SECTION 34 TOWNSHIP 15 RANGE 2
DATE: ~~12-17-95~~ 4-25-2000
PARTY CHIEF: ~~Wilcoxen~~ Kiste
CREW:
TYPE OF MARKER: 1" rebar Fd
METHOD OF ESTABLISHMENT: County

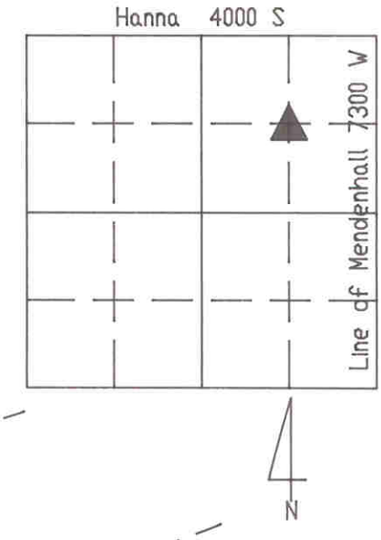

IN. S.P.C. E ZONE, NAD 83
NAME: 15023415
N: 494695.7840(m)
E: 46282.4205(m)

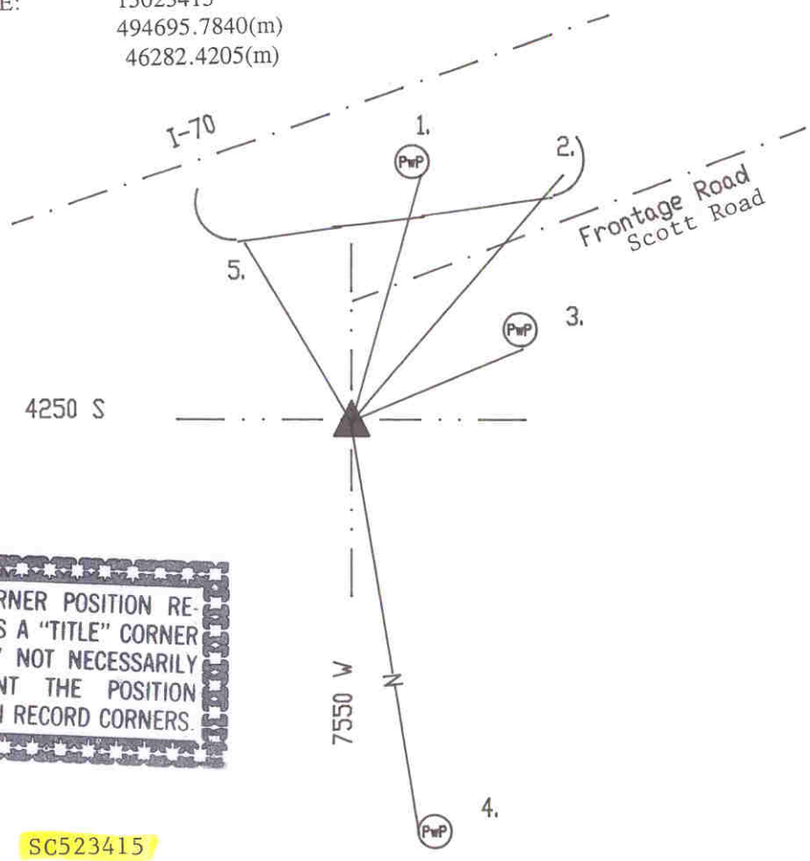

THIS CORNER POSITION REPRESENTS A "TITLE" CORNER AND MAY NOT NECESSARILY REPRESENT THE POSITION BASED ON RECORD CORNERS.

SC523415

REF.	DISTANCE	DESCRIPTION
1.	75.49'	PK E PwP#5-651B 30"up
2.	82.29'	'x' in bolt in guard rail
3.	50.53'	PK S PwP#82-651Z 12"up
4.	217.21'	PK W PwP#4-651Z 10"up
5.	58.22'	'x' in bolt in guard rail