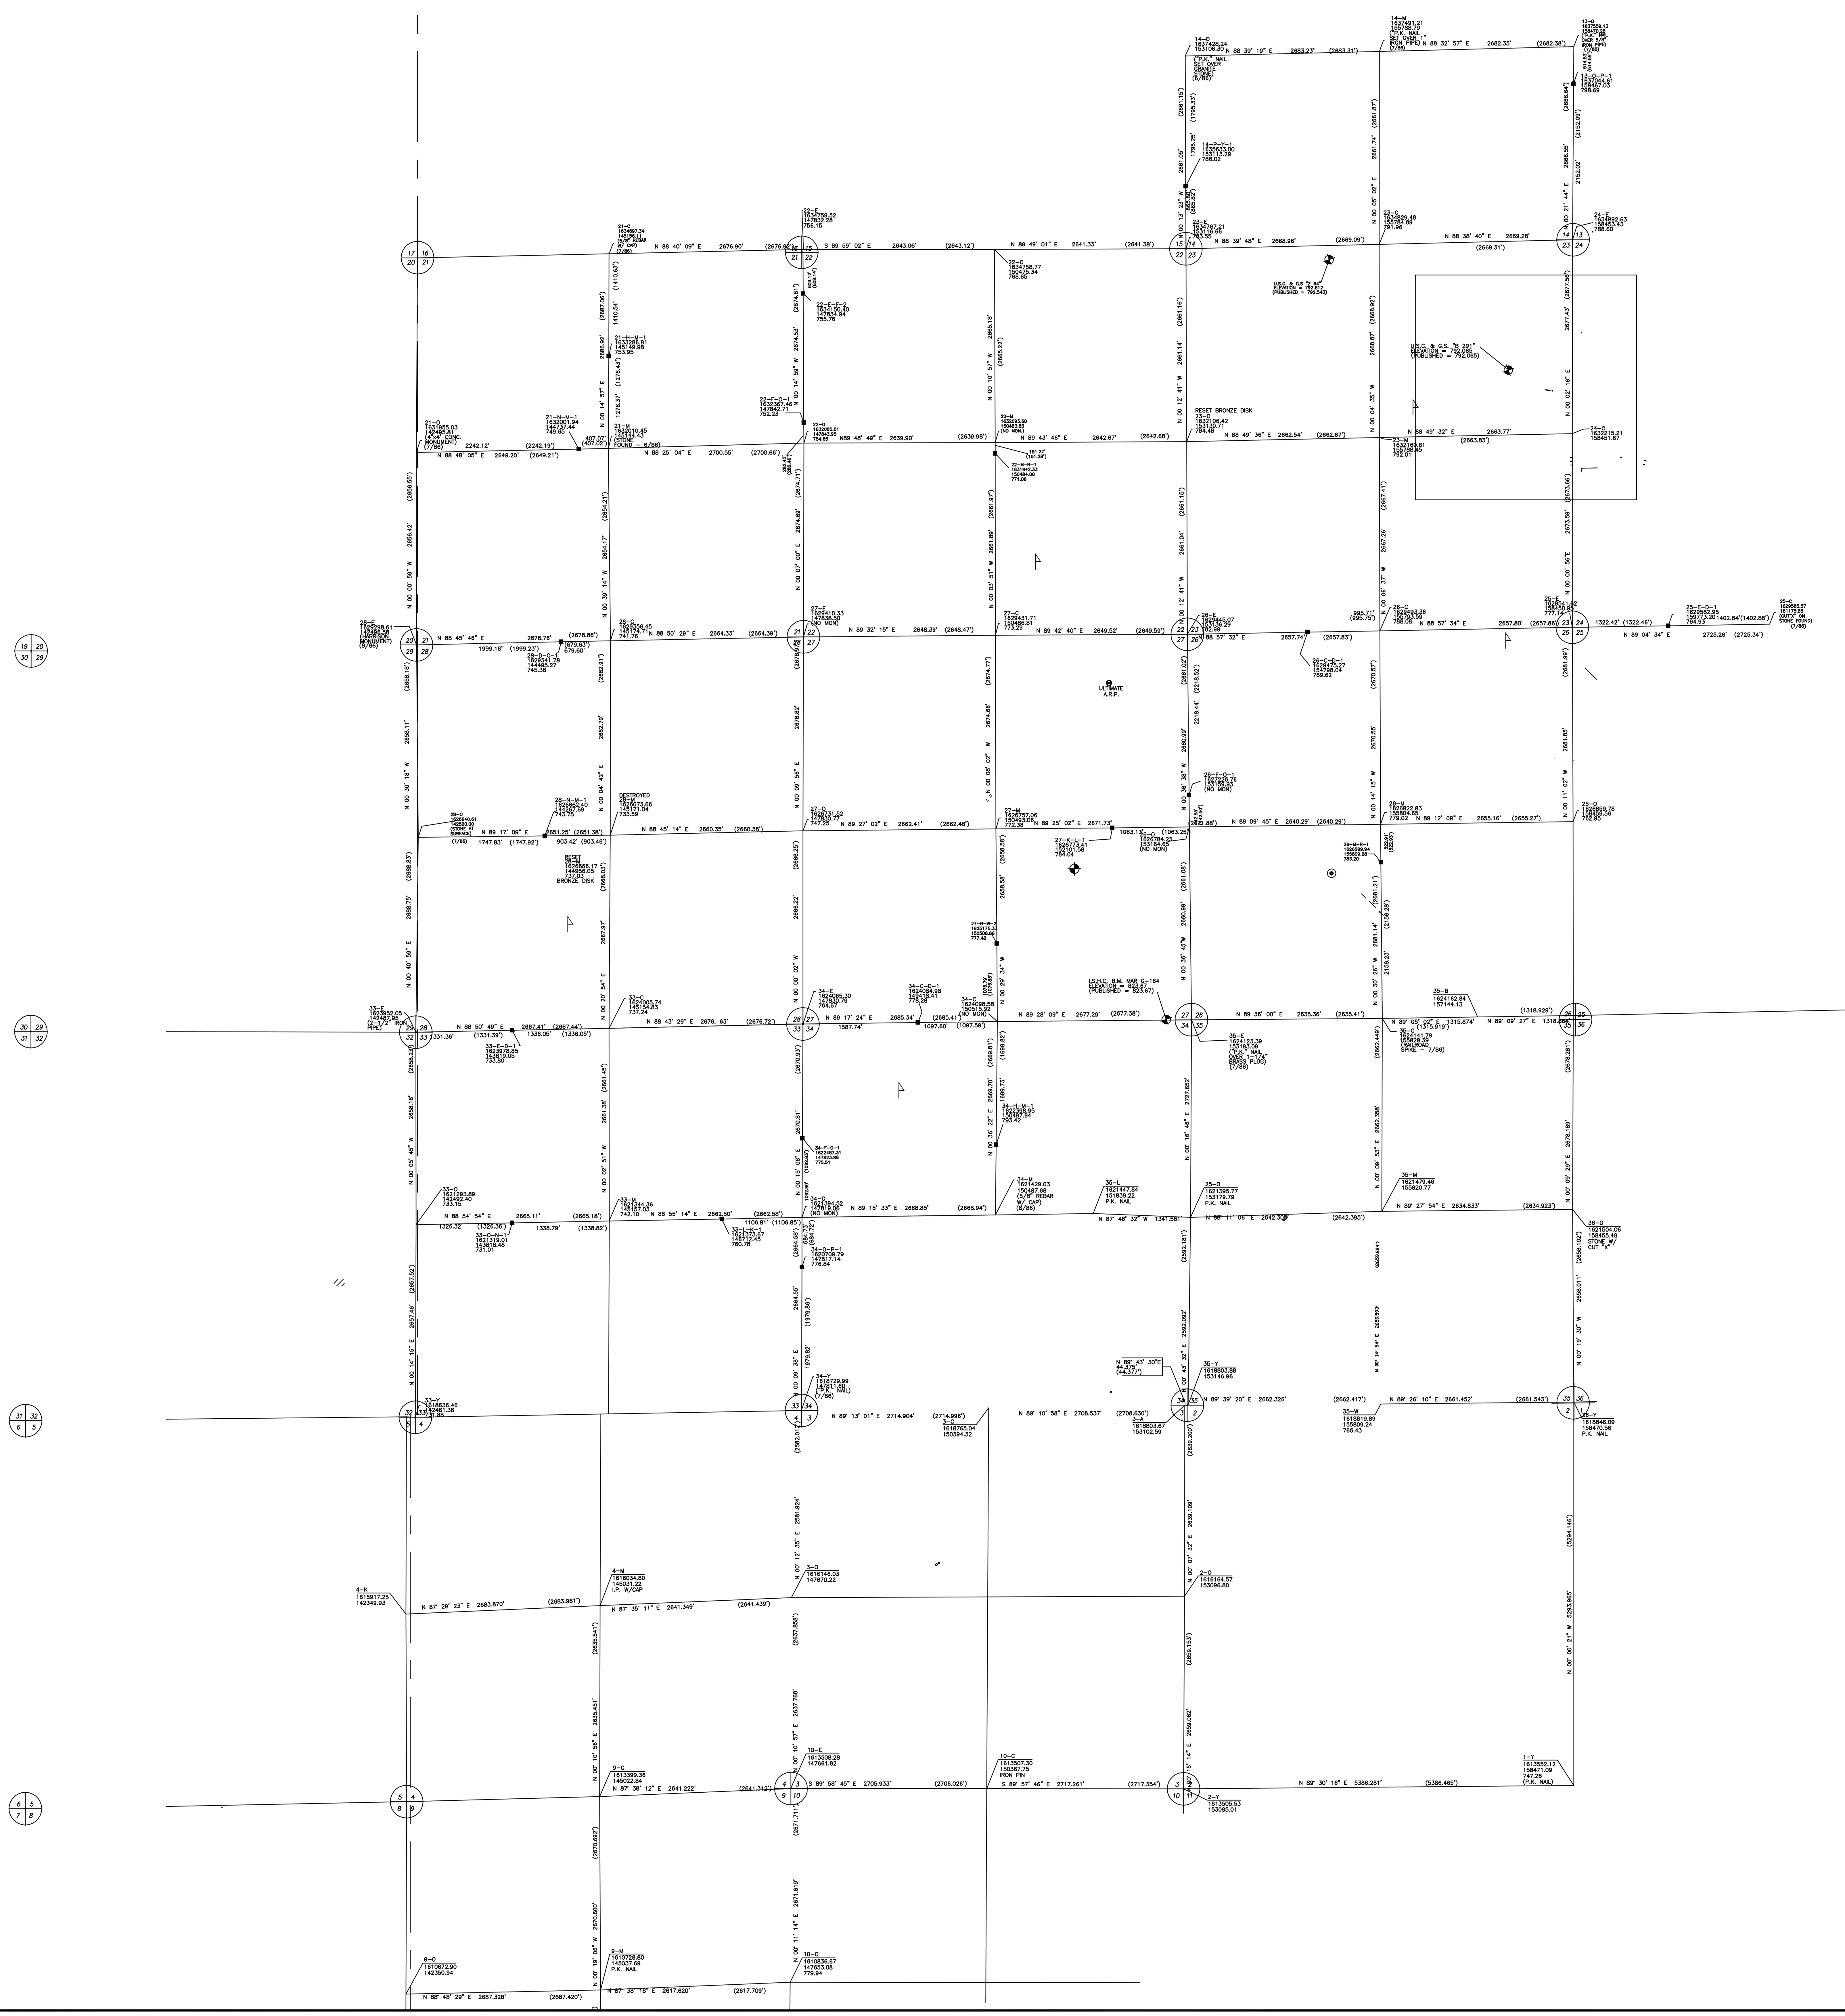

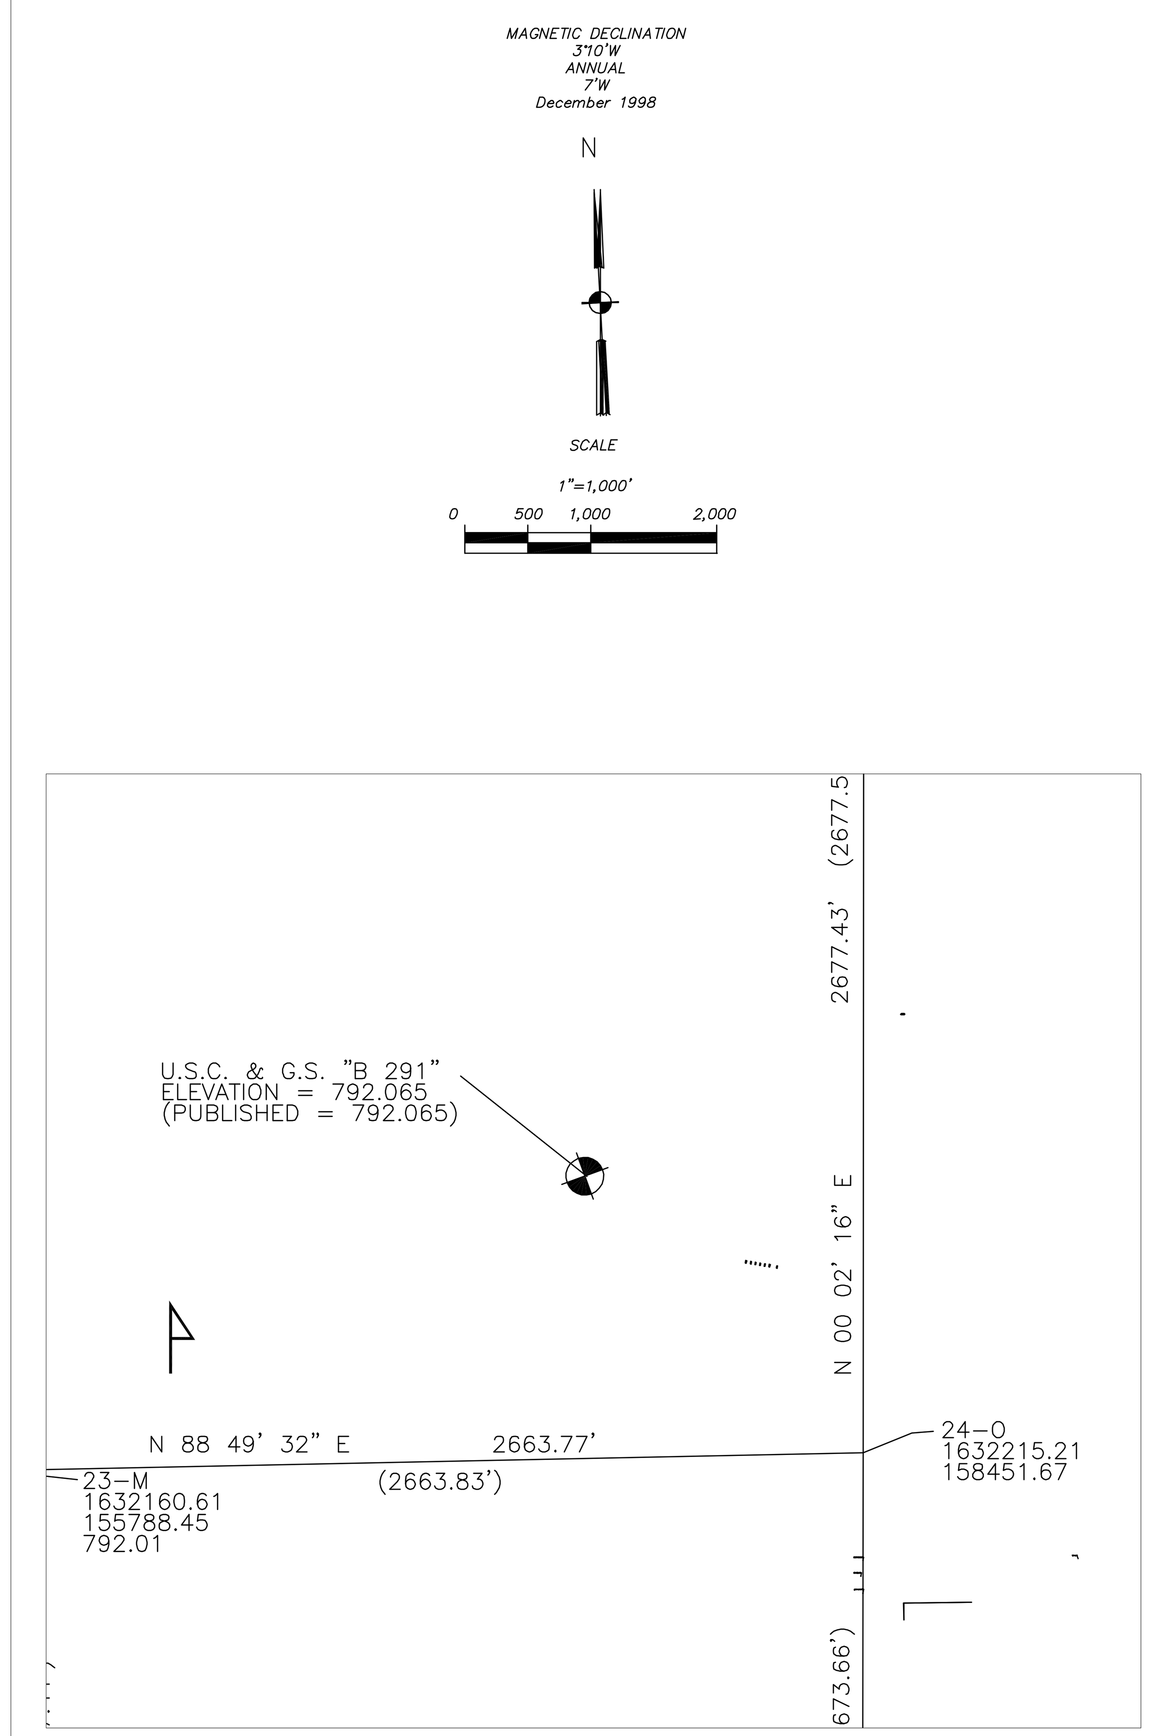

NO.	DATE	REVISIONS	BY	APPR.
3				
2	2-22-2006	Update I-70 development	ILJ	SJZ
1	2-22-2006	Update Runway 14-32 and future Runway 5L-23R length and midfield terminal area	ILJ	SJZ

BAA Indianapolis

AIRPORT
INDIANAPOLIS INTERNATIONAL AIRPORT

PROJECT
AIRPORT LAYOUT PLAN UPDATE

SHEET TITLE
ON-AIRPORT MONUMENT SYSTEM

SCALE: 1" = 1,000'

DATE: 08-04-00

NO. 19 OF 23

PLANS PREPARED BY AEROFINITY, INC.

DESIGNED	DRAWN	CHECKED	APPROVED
SJZ	ILJ	MKD	SMS