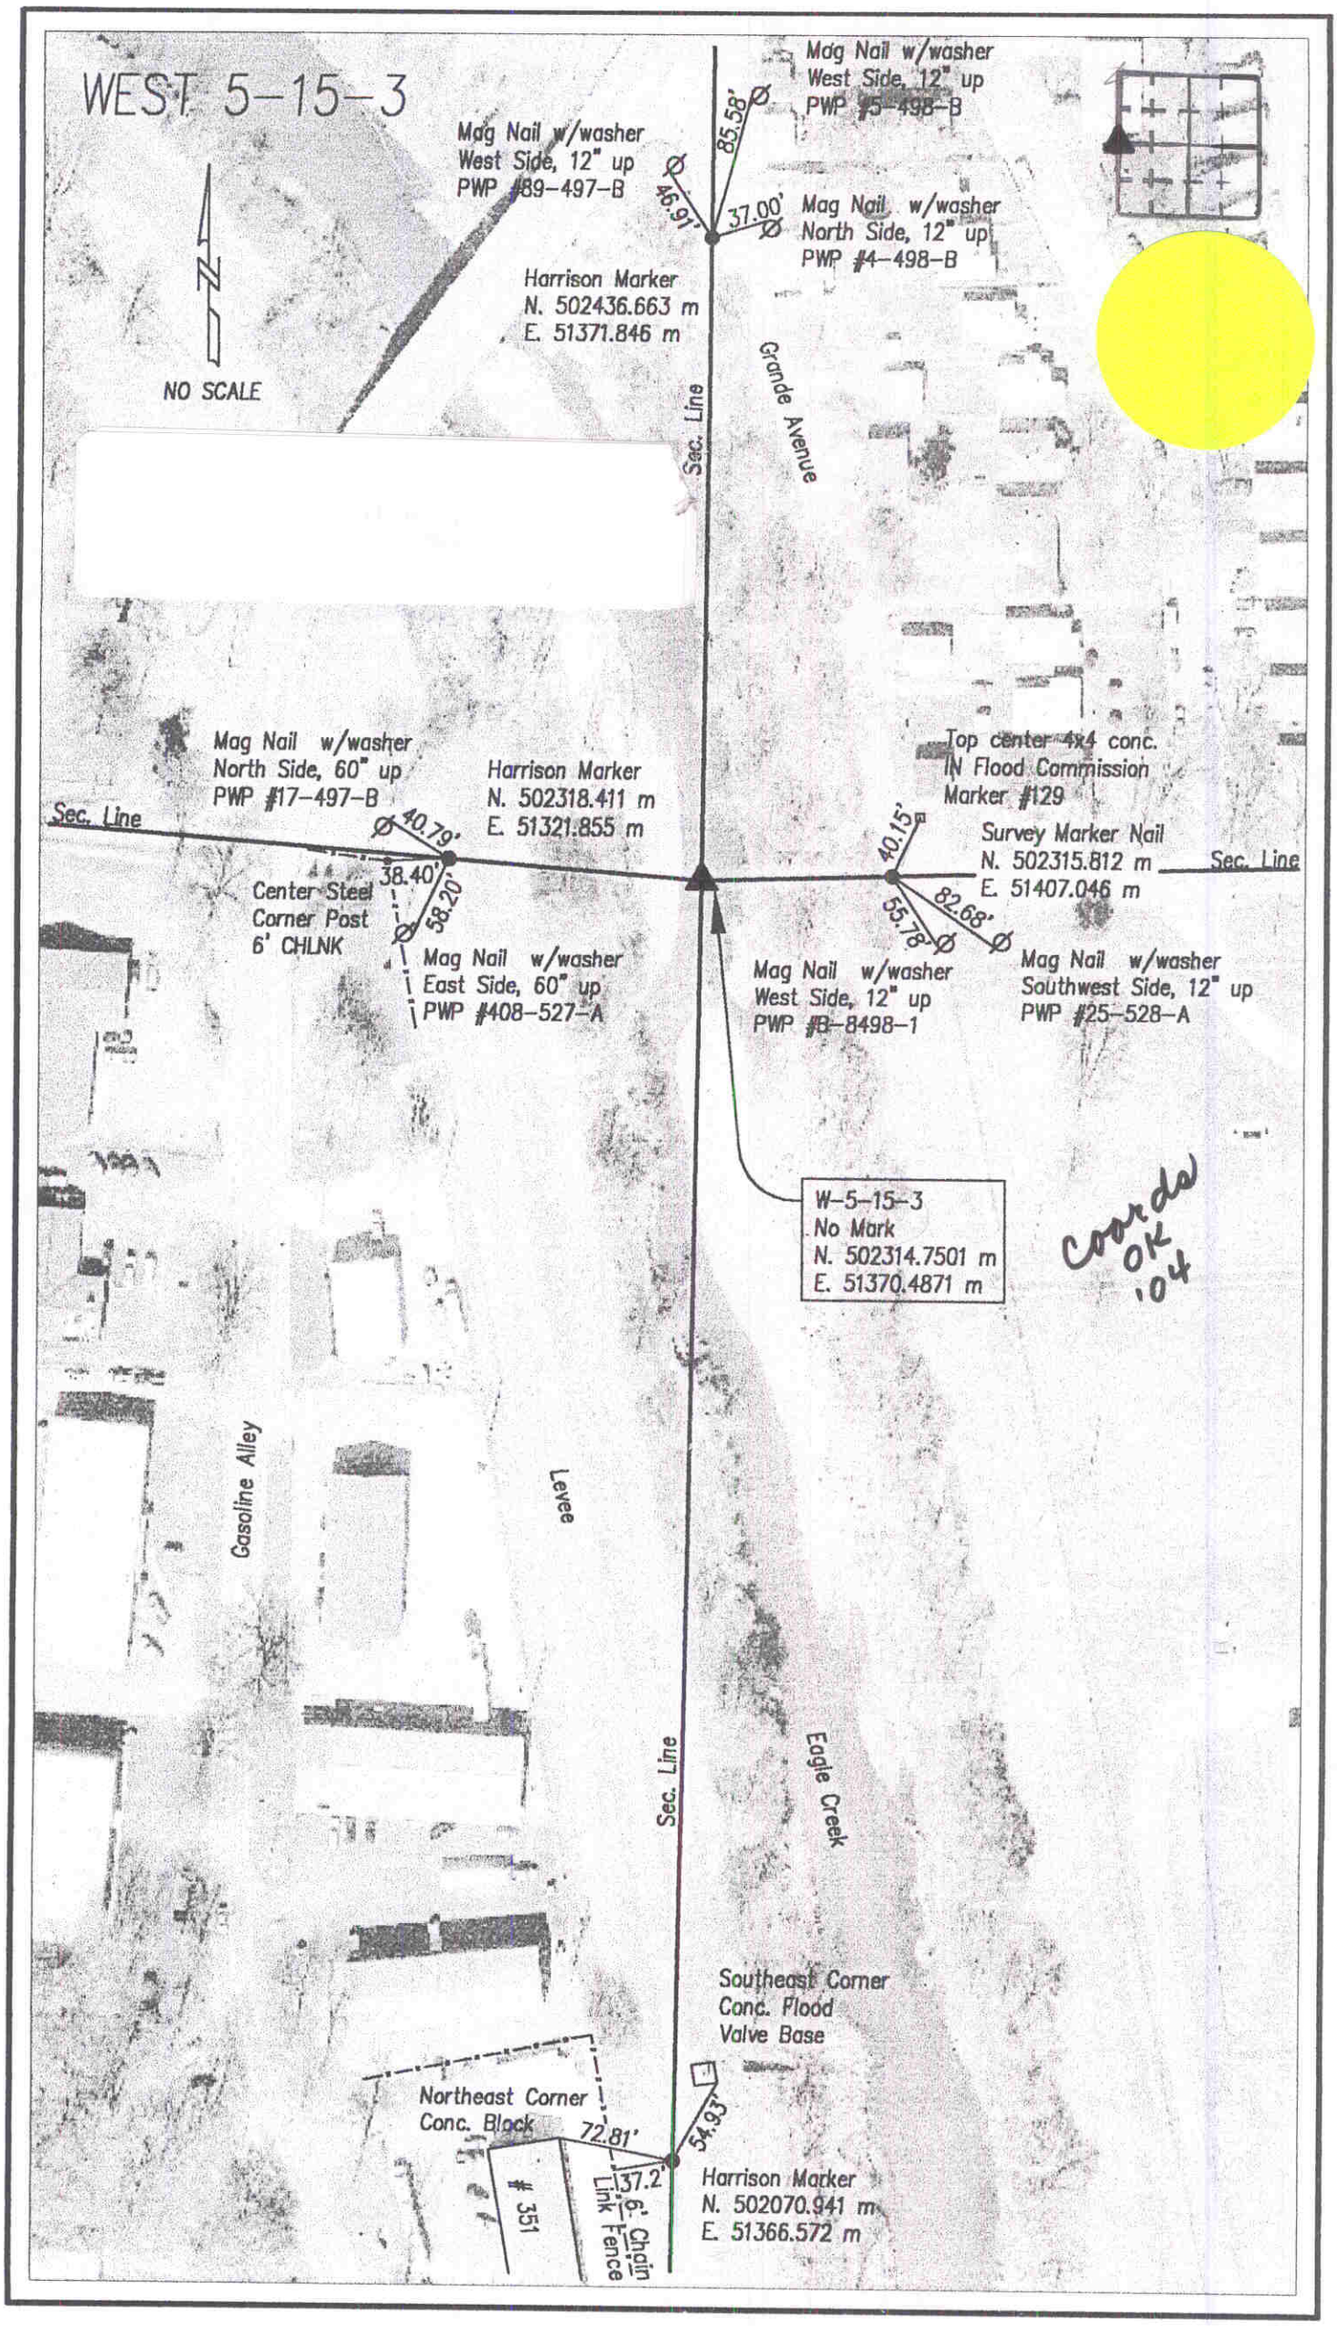
WEST 5-15-3
NO SCALE
Mag Nail w/washer
West Side, 12" up
PWP #89-497-B
46.91'
Mag Nail w/washer
West Side, 12" up
PWP #5-498-B
85.58'
37.00'
Mag Nail w/washer
North Side, 12" up
PWP #4-498-B
Harrison Marker
N. 502436.663 m
E. 51371.846 m
Sec. Line
Grande Avenue
Mag Nail w/washer
North Side, 60" up
PWP #17-497-B
Harrison Marker
N. 502318.411 m
E. 51321.855 m
Sec. Line
40.79'
38.40'
58.20'
Center Steel
Corner Post
6' CHLNK
Mag Nail w/washer
East Side, 60" up
PWP #408-527-A
Top center 4x4 conc.
IN Flood Commission
Marker #129
40.15'
Survey Marker Nail
N. 502315.812 m
E. 51407.046 m
Sec. Line
82.68'
55.78'
Mag Nail w/washer
West Side, 12" up
PWP #B-8498-1
Mag Nail w/washer
Southwest Side, 12" up
PWP #25-528-A
W-5-15-3
No Mark
N. 502314.7501 m
E. 51370.4871 m
Coords OK '04
Gasoline Alley
Levee
Sec. Line
Eagle Creek
Southeast Corner
Conc. Flood
Valve Base
Northeast Corner
Conc. Block
72.81'
54.93'
137.2'
351
6' Chain Link Fence
Harrison Marker
N. 502070.941 m
E. 51366.572 m