OFFICE OF THE MARION COUNTY SURVEYOR
SECTION RECORD CORNER
SECTION 7 TOWNSHIP 15 RANGE 3
DATE: 6-22-06
PARTY CHIEF: Wilcoxen
CREW:
TYPE OF MARKER: Harrison
METHOD OF ESTABLISHMENT: County: 8-4-99

IN. S.P.C. E ZONE NAD '83
NAME: 15030704
N: 500793.7022(m)
E: 5995.2026(m)

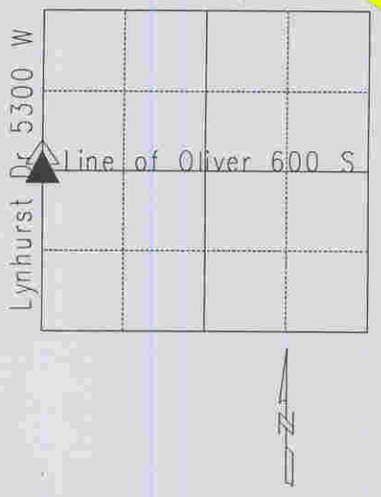

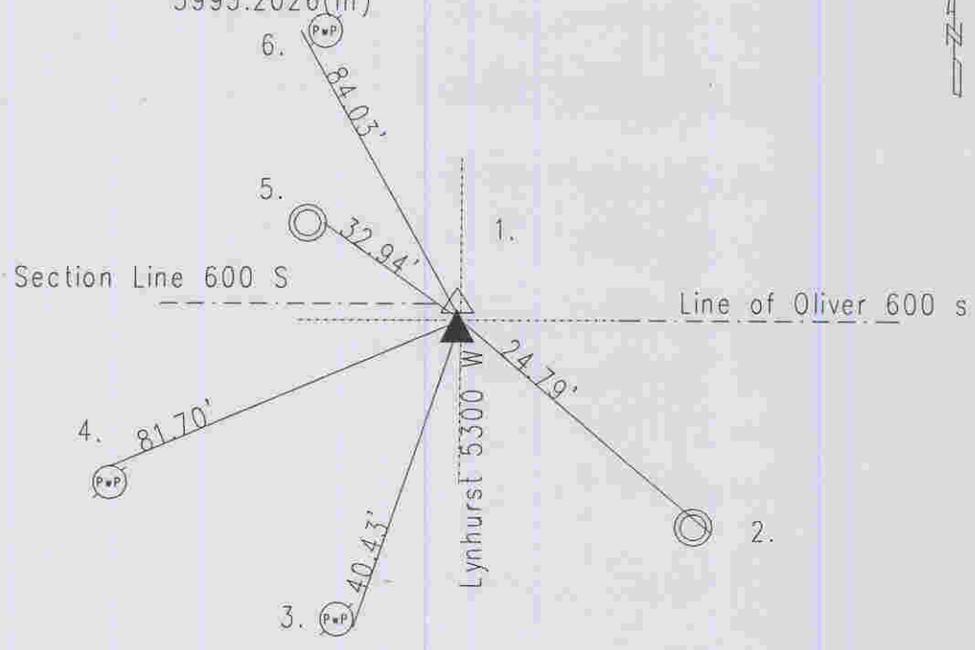

Original post set 1820 by Wm. B. Laughlin with witness: 12" sugar N 5 E 25 links; 18" beech S 42 W 13 links per Marion County Atlas pg. 6. Survey by Percy Hosbrook 12-12-1848 indicates no stone nor witness per Wayne Township Legal Survey Book pg. 82. Monroe 8-11-52 called a bolt. GWS 1-7-64 called a PK nail. Miller 7-17-75 called a road nail with washer. Miller 10-24-75 called a road nail with washer. Greene 11-24-86 called a road nail with washer. Wilcoxen 9-28-96 called a mag nail with washer set. Excavated by Wilcoxen 8-4-99 and set Harrison . No points were found. Re-tied 6-22-06 by Wilcoxen.

15030704

REF.	DISTANCE	DESCRIPTION
1.	4.69'	Due N to F Q 12-15-2 Harrison
2.	24.79'	Cut 'x' SF rim of bell telephone manhole
3.	40.43'	PK nail NF PwP#420-555 3"up
4.	81.70'	Mag nail w/bw N PwP#421-555 6"up
5.	32.94'	Cut 'x' E edge of sewer manhole
6.	84.03'	Mag nail w/bw W PwP#1-525B 6"up