OFFICE OF THE MARION COUNTY SURVEYOR
SECTION RECORD CORNER
SECTION 8 TOWNSHIP 15 RANGE 3
DATE: ~~-6-6-01~~ 5-23-06
PARTY CHIEF: Wilcoxen
CREW: Survey mark nail
TYPE OF MARKER: ~~Mag nail w/brass washer~~
METHOD OF ESTABLISHMENT: County: 7-22-96

IN. S.P.C. E ZONE, NAD 83
NAME: 15030804
N: 500686.0730(m)
E: 51344.3350(m)

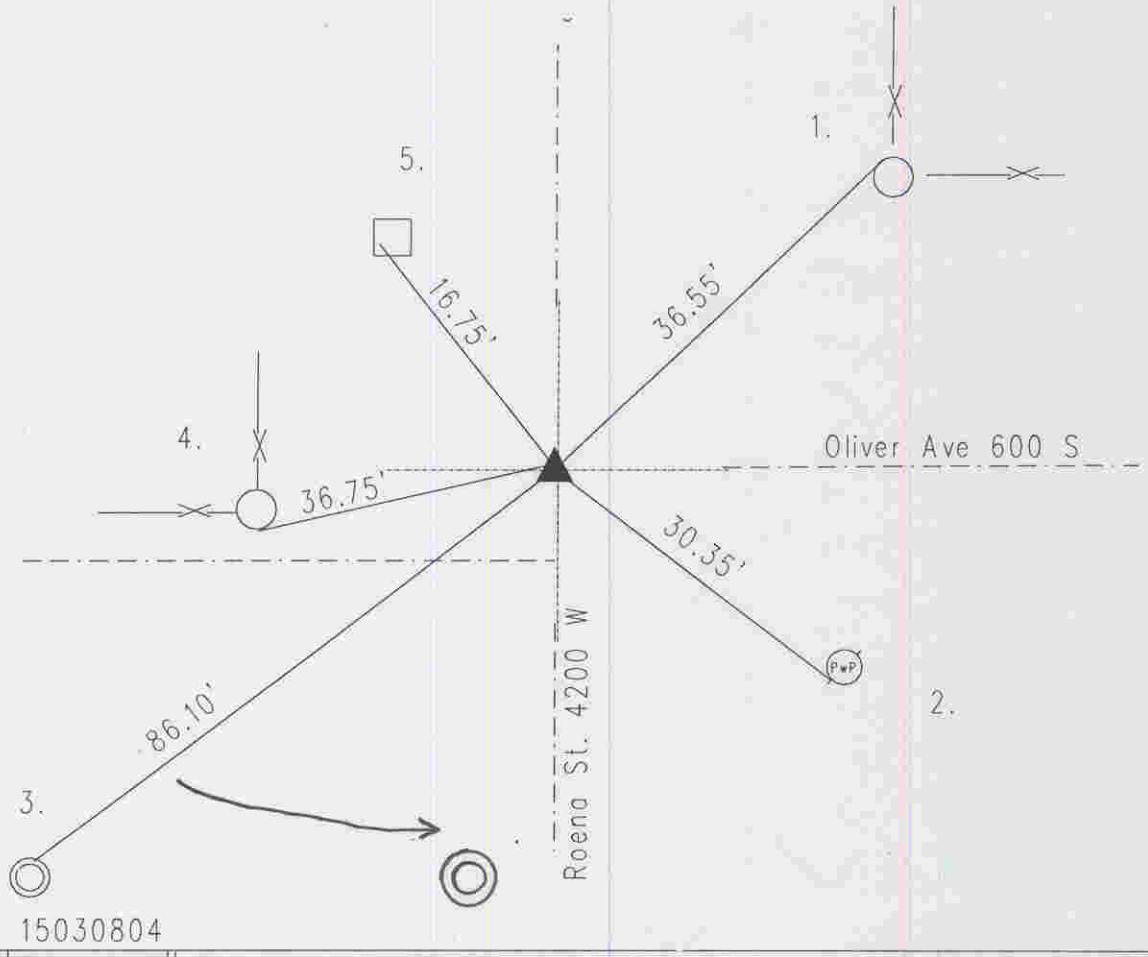

REF.	DISTANCE	DESCRIPTION
1.	36.55'	Cut 'x' NW steel corner post
2.	30.35'	PK nail SW PwP#370-558A 8"up
3.	86.10'	Cut 'x' N-rim sewer manhole
4.	36.75'	Cut 'x' S corner fence post 8"up
5.	16.75'	Cut 'x' SW storm inlet