SECTION RECORD CORNER
SECTION 20 TOWNSHIP 15 RANGE 3
DATE: 6-12-06
PARTY CHIEF: Wilcoxen
CREW:
TYPE OF MARKER: Survey mark nail set
METHOD OF ESTABLISHMENT: County: 6-19-01

NOTE: This corner position represents a title corner and may not necessarily be in the position of the Record corner.

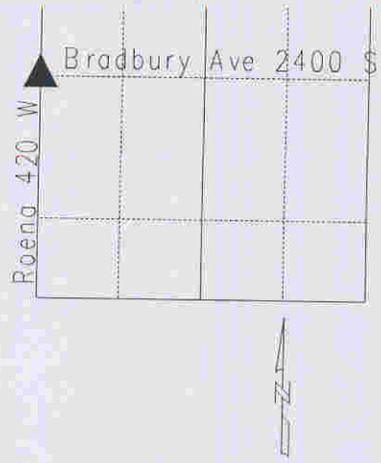

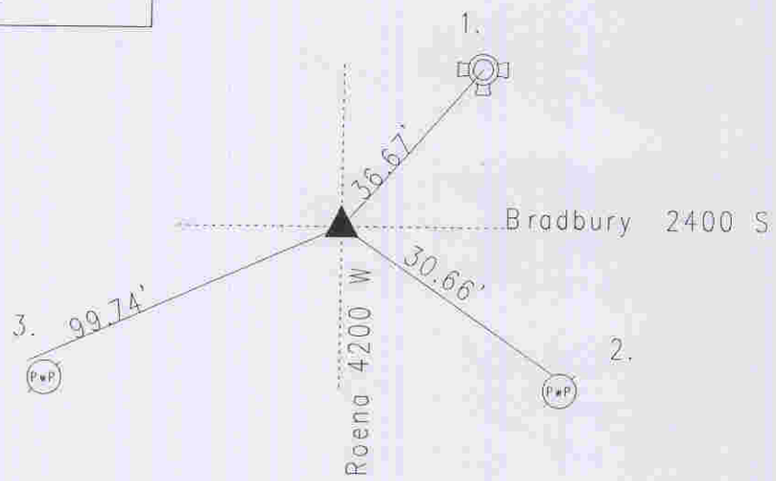

15032012

REF.	DISTANCE	DESCRIPTION
1.	36.67'	Top nut of fire hydrant
2.	30.66'	PK nail w/washer N PwP#1-598 B 2"up
3.	99.74'	PK nail N PwP#1-597B 12"up