OFFICE OF THE MARION COUNTY SURVEYOR
SECTION RECORD CORNER
SECTION 24 TOWNSHIP 15 RANGE 3
DATE: 10-09-08
PARTY CHIEF: Wilcoxen
CREW:
TYPE OF MARKER: Harrison Monument
METHOD OF ESTABLISHMENT: County: 11-13-06

IN. S.P.C. E ZONE NAD '83
NAME: 15032404
N: 497628.2318(m)
E: 57803.2427(m)

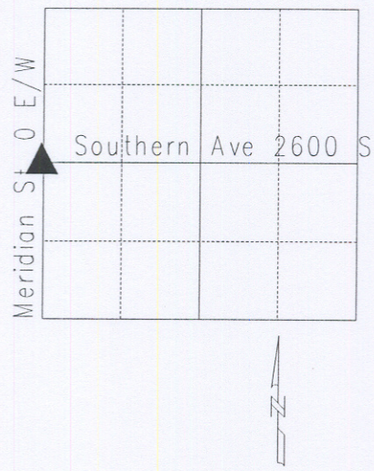

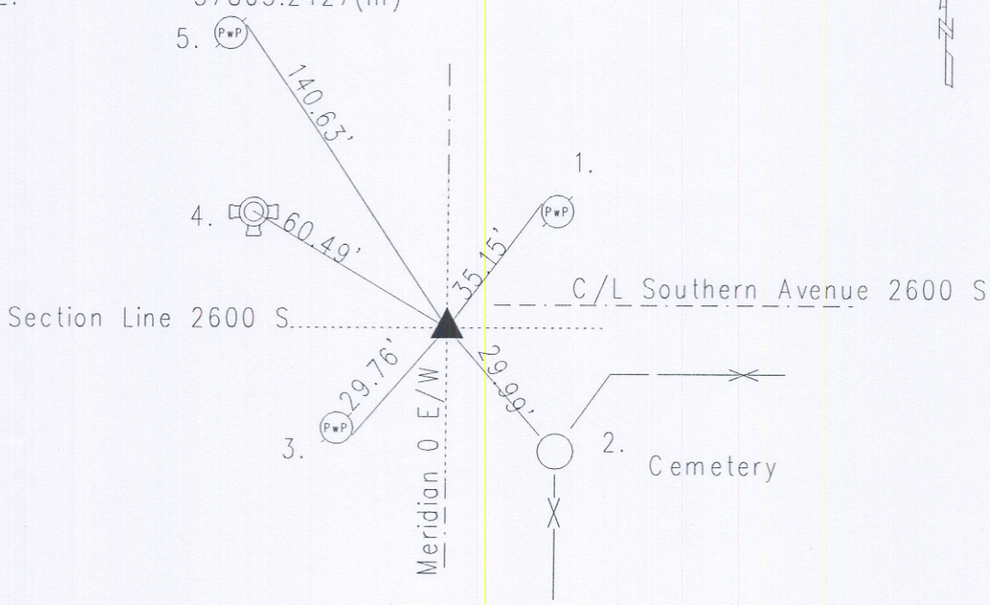

Corner History: Marion County Atlas 1883 page 6 references witness: 14" sugar N 43 E 21 links; 12" buckeye S 58 W 26 links. Corner reference per Center Township Legal Survey Book 1, page 47 dated February 22, 1876 by Fatout. Corner reference dated 1-16-1976 by Wilcoxen called PK nail. Corner reference dated 1-29-1987 by Wilcoxen called same. Corner reference dated 6-1-1995 by Greene called same. Corner reference dated 6-23-01 by Wilcoxen called PK nail found. Corner reference dated 11-13-2006 by Wilcoxen called PK nail fd. Corner reference dated 10-09-08 by Wilcoxen called Set Harrison by ties and GPS coordinates, fd old nail 3" down.

15032404

REF.	DISTANCE	DESCRIPTION
1.	35.15'	PK nail NW PwP#1-606B 3"up
2.	29.99'	Face of chain link fence post
3.	29.76'	Mag nail w/bw SF PwP#44-635A 8"up
4.	60.49'	Top nut of fire hydrant
5.	140.63'	Mag nail w/bw F PwP#274-635A 14"up