OFFICE OF THE MARION COUNTY SURVEYOR
SECTION RECORD CORNER
SECTION 25 TOWNSHIP 15 RANGE 3
DATE: 6-28-06
PARTY CHIEF: Wilcoxen
CREW:
TYPE OF MARKER: Harrison
METHOD OF ESTABLISHMENT: County: 6-24-01

IN. S.P.C. E ZONE NAD '83
NAME: 15032503
N: 496839.5163(m)
E: 59457.4549(m)

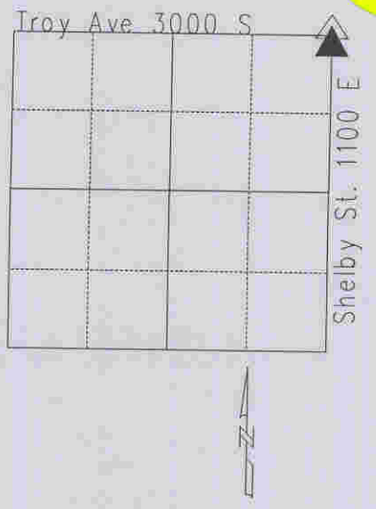

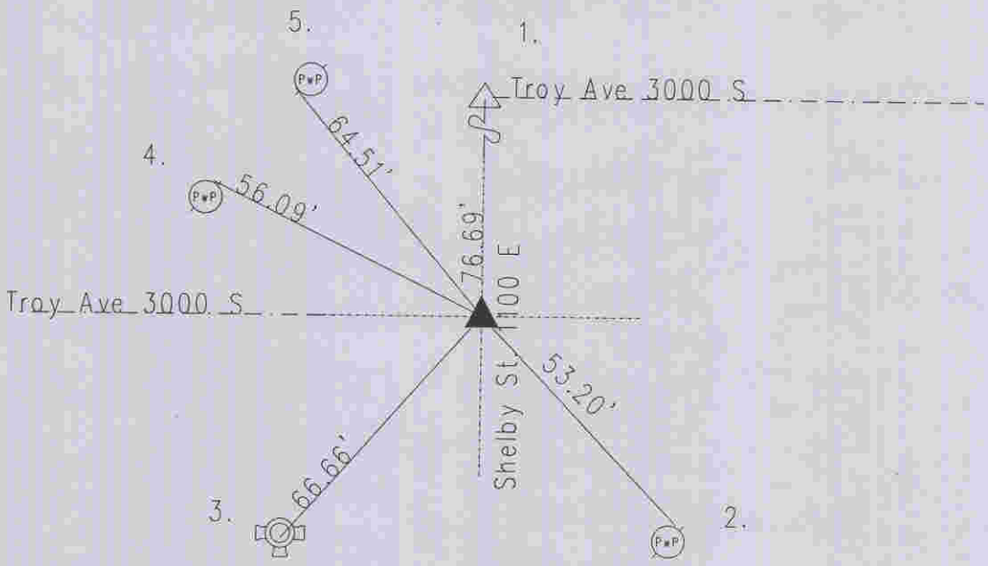

Original post set in 1820 by Laughlin with witness: 7" beech N 50 E 19 links; 20" hickory S 32 W 46 links per Marion County Atlas, pg. 6. Hosbrook 4-26-1853 called no stone nor witness. Schmidt 2-13-62 called a brass plug. Miller 9-23-75 called the same. Greene 11-17-86 called the same. Excavated by Green 7-15-96 and Harrison set. Re-tied 6-24-01 by Wilcoxen. Re-tied 6-28-06 by Wilcoxen.

15032503

REF.	DISTANCE	DESCRIPTION
1.	76.69'	Due N to SW corner of 19-15-4 (Harrison)
2.	53.20'	Mag nail w/bw NF PwP#79-638 B 8"up
3.	66.66'	Top nut of fire hydrant
4.	56.09'	Mag nail w/bw NF PwP#44-637 10"up
5.	64.51'	Mag nail w/bw SW PwP#316-637 A 6"up