OFFICE OF THE MARION COUNTY SURVEYOR
SECTION RECORD CORNER
SECTION 35 TOWNSHIP 15 RANGE 3
DATE: ~~10-5-99~~ 9-27-04
PARTY CHIEF: ~~Kiste~~ Wilcoxen
CREW:
TYPE OF MARKER: PK nail w/MCS washer found
METHOD OF ESTABLISHMENT: County: 6-16-93

IN. S.P.C. E ZONE, NAD 83
NAME: 15033501
N: 495162.8140(m)
E: 56216.5990(m)

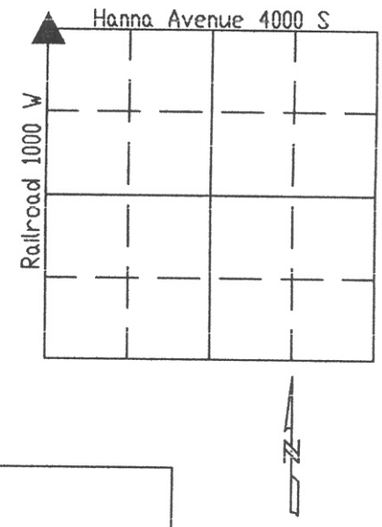

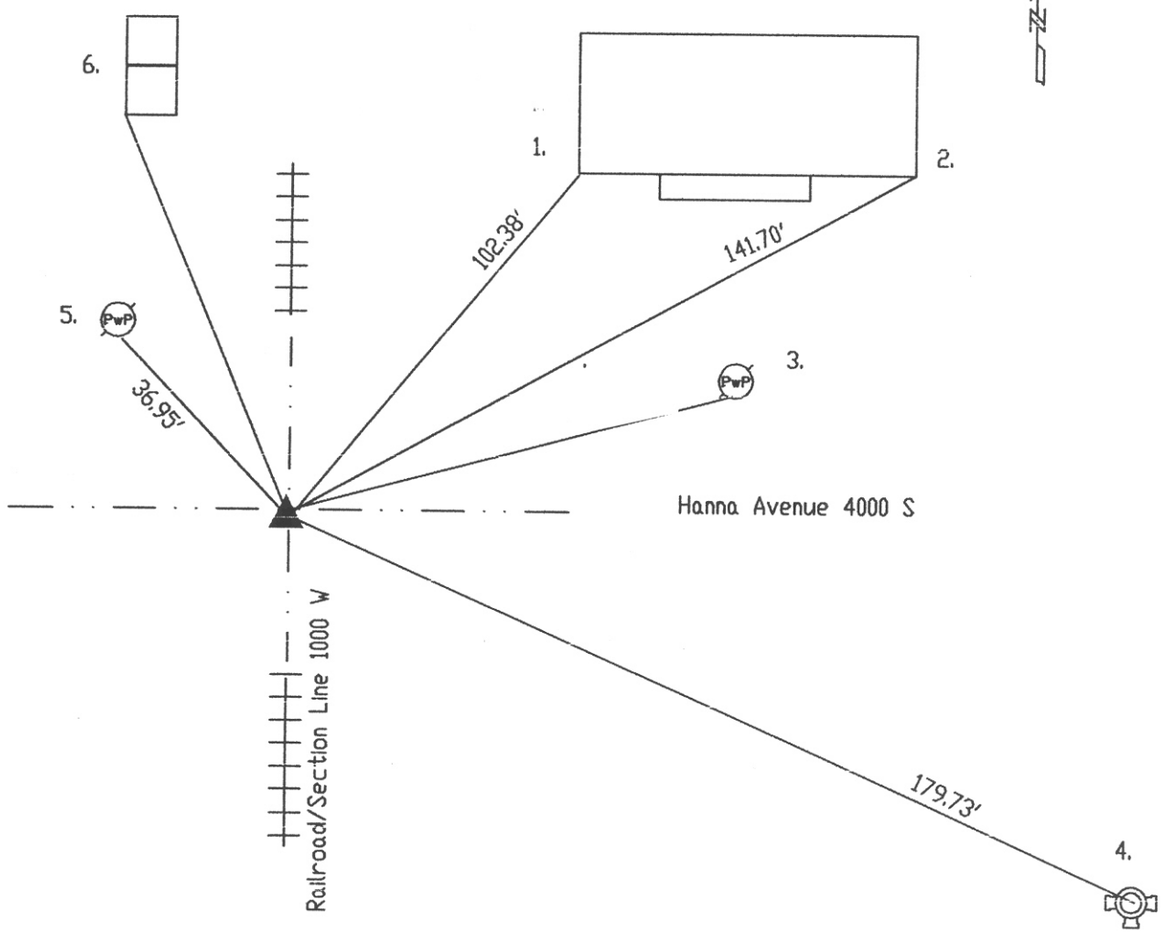

SC533501

REF.	DISTANCE	DESCRIPTION
1.	102.38'	SW corner of ADDRESS #956
2.	141.70'	SE corner of "
3.	88.00'	PK nail S PwP no# 12"up
4.	179.73'	Top nut of fire hydrant
5.	36.95'	PK nail S PwP#32-663A 10'up
6.	85.23'	SW corner of bell telephone concrete base