The OFFICE of the MARION COUNTY SURVEYOR

SECTION CORNER RECORD
MARION COUNTY, INDIANA

Sec. 8 Twp. 15 Range 4

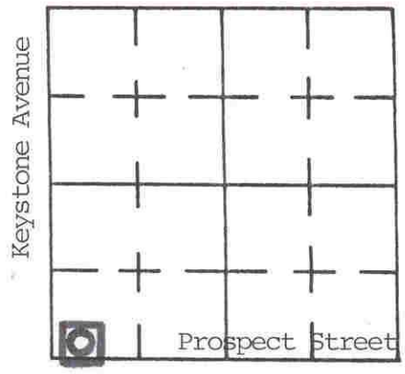

DATE: ~~8-20-91~~ 4-30-2000

CREW: P.C.- ~~Greene/Glass~~ Wilcoxen

INST. - ROD. -

TYPE of MARKER: Benchmark: COND. of MARKER: Good:

METHOD of ESTABLISHMENT:

N 1640875.03313

E 200349.58760

Elevation: 742.388

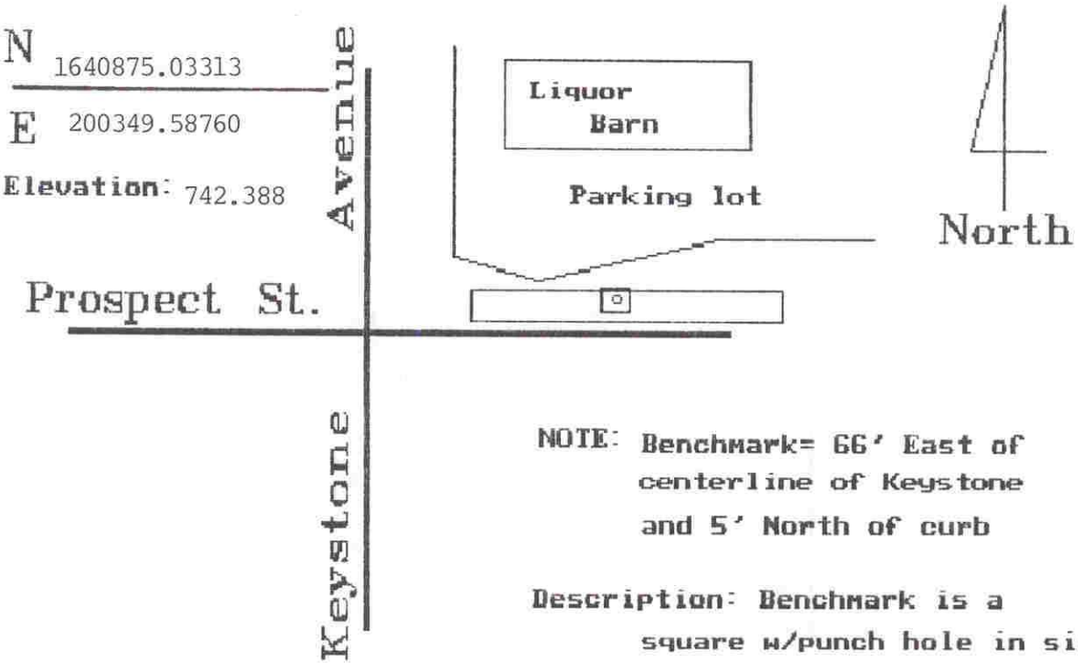

NOTE: Benchmark= 66' East of centerline of Keystone and 5' North of curb

Description: Benchmark is a square w/punch hole in sidewalk.

Job# 910048

PX5408A

General coordinates are:
Prospect Street: 1100S
Keystone Avenue: 2400E

CS-0001