OFFICE OF THE MARION COUNTY SURVEYOR
SECTION RECORD CORNER
SECTION 12 TOWNSHIP 15 RANGE 4
DATE: 5-8-04
PARTY CHIEF: Wilcoxen
CREW:
TYPE OF MARKER: Railroad spike Fd over stone
METHOD OF ESTABLISHMENT: County: 12-14-98
EDM ties

NOTE: This corner position represents a title corner and may not necessarily be in the position of the Record corner.

IN.S.P.C. E ZONE NAD'83
Name: 15041217
N: 501104.1750(m)
E: 67975.2120(m)

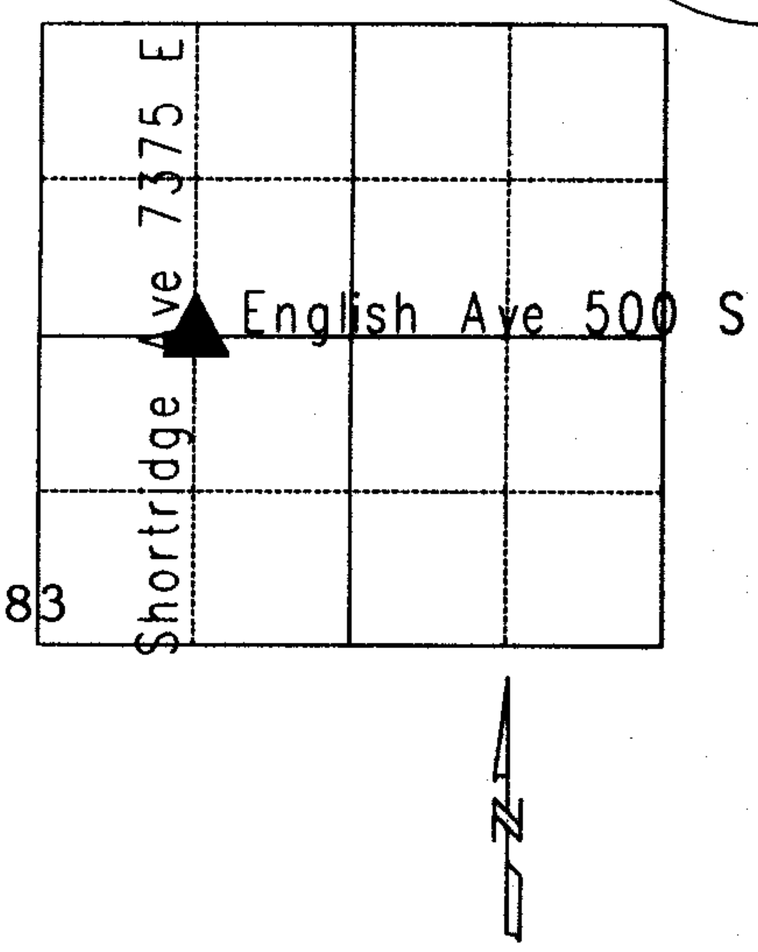

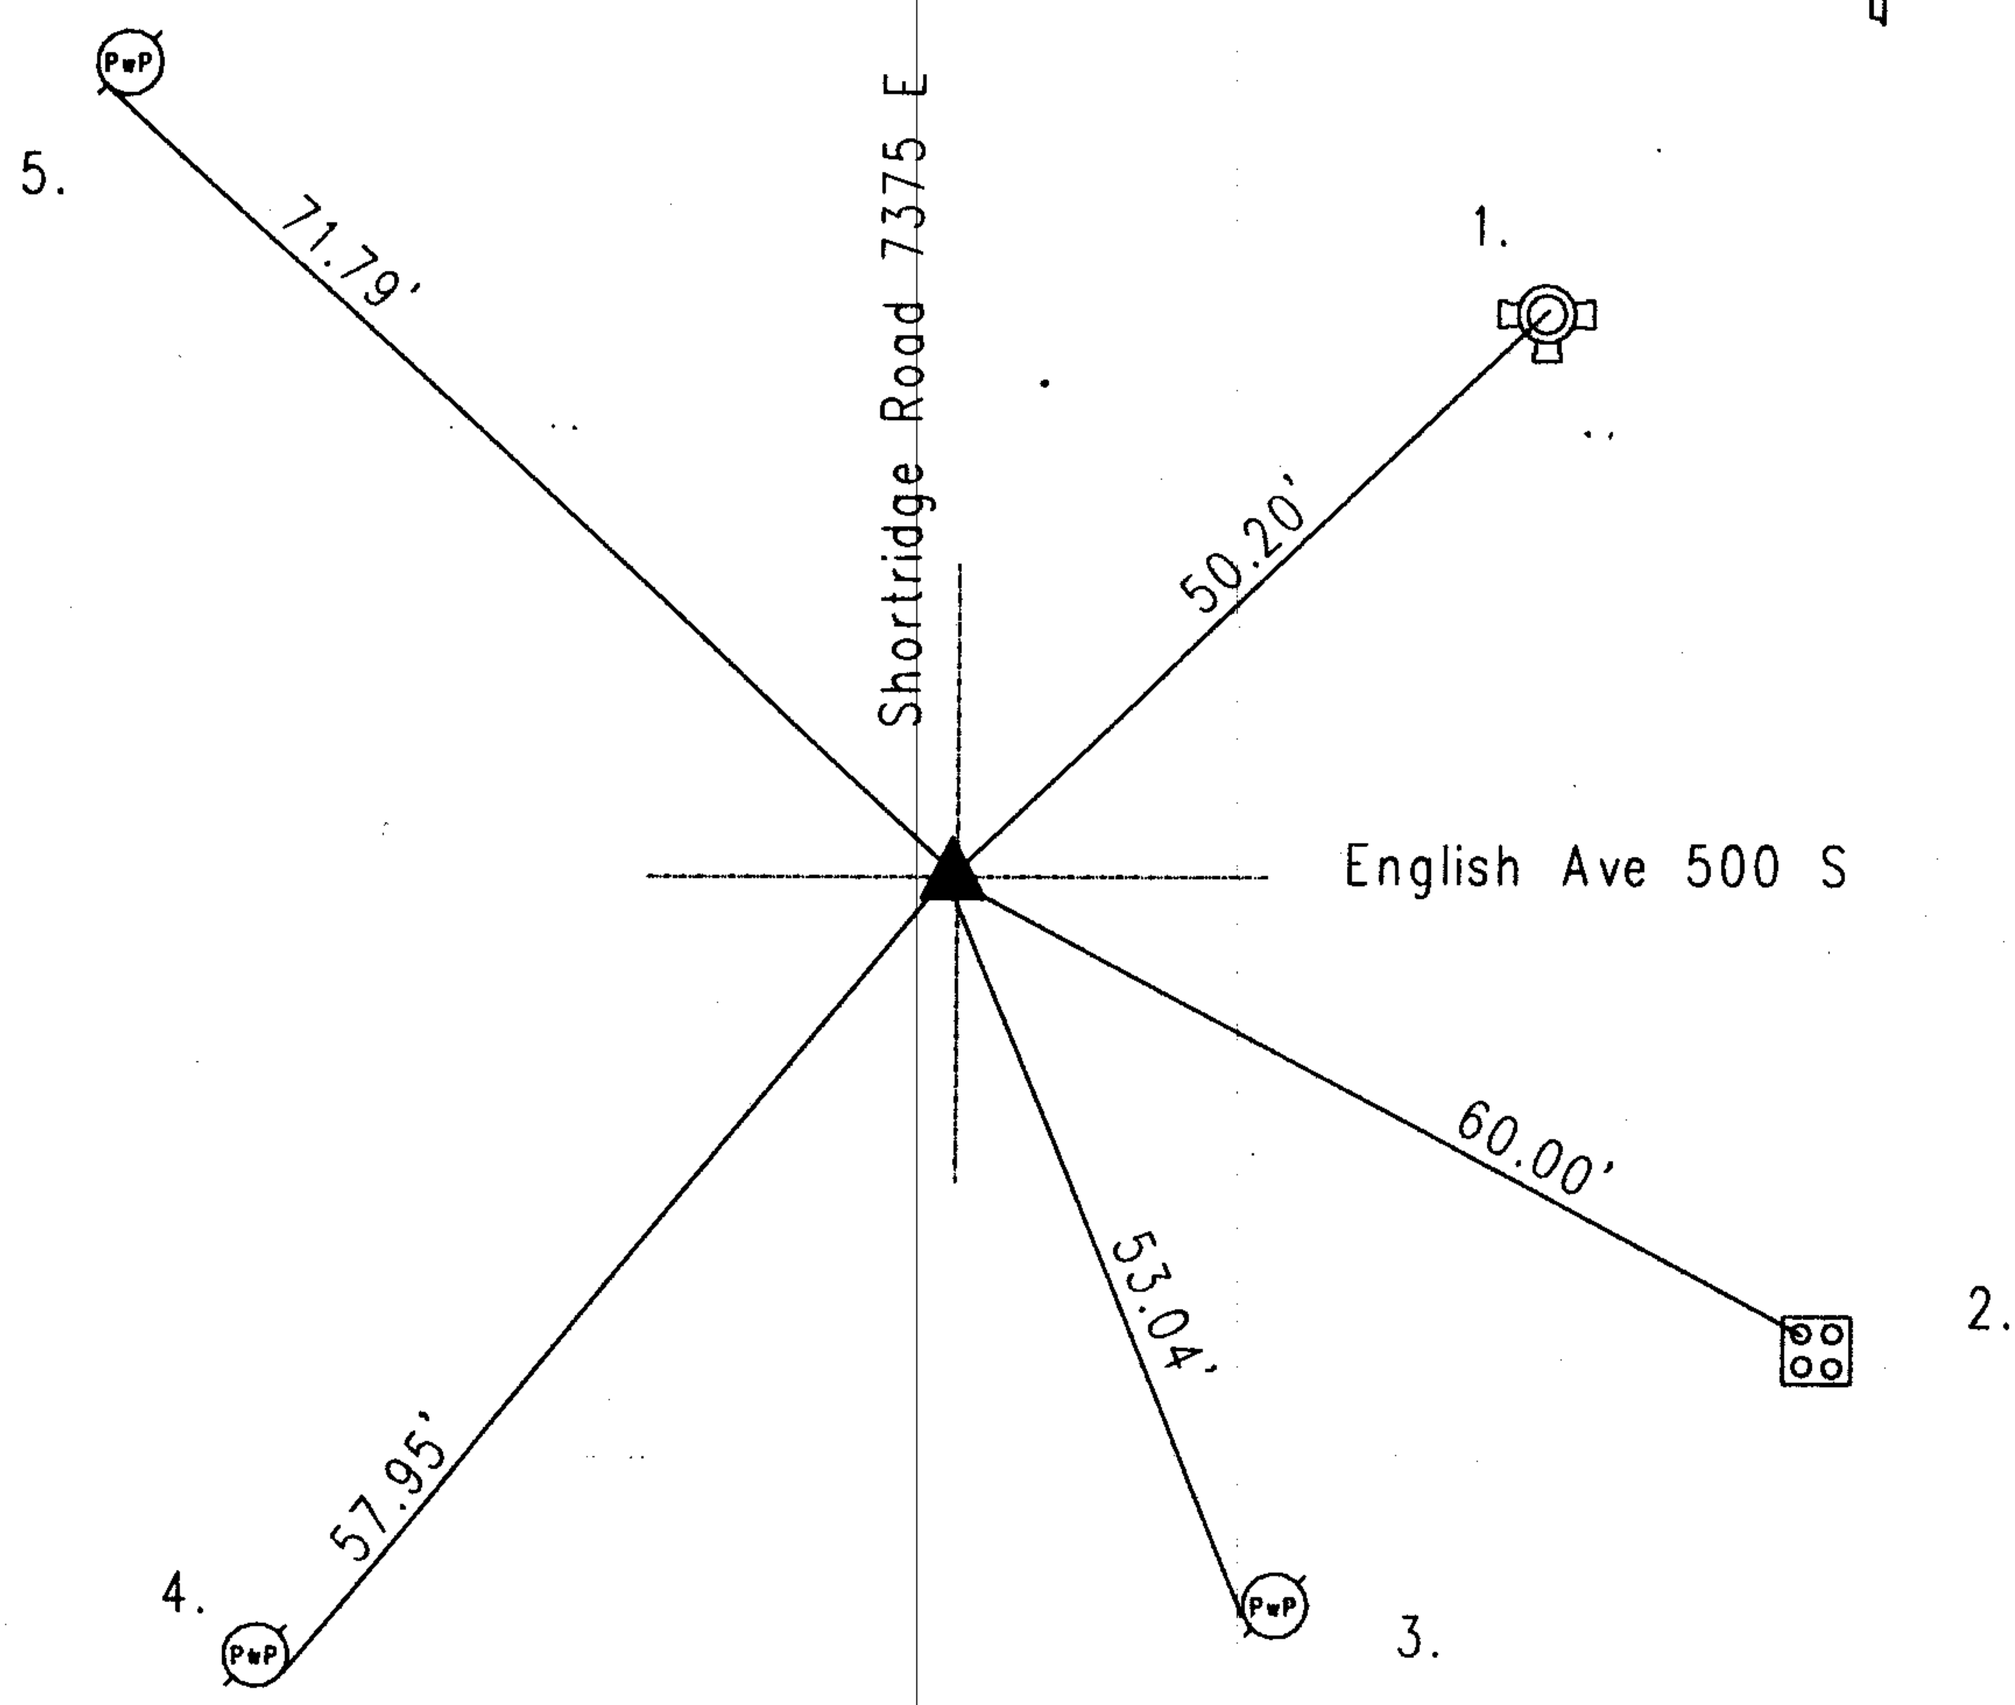

SX541217

REF.	DISTANCE	DESCRIPTION
1.	50.20'	Top nut of fire hydrant
2.	60.00'	Cut 'x' in NW bolt of railroad crossing signal base
3.	53.04'	PK nail SW guide pole no# 15"up
4.	57.95'	Large road nail SE PwP#32-578 A 12"up
5.	71.79'	PK nail SW PwP#149-548 18"up