OFFICE OF THE MARION COUNTY SURVEYOR
SECTION RECORD CORNER
SECTION 14 TOWNSHIP 15 RANGE 4
DATE: ~~10-30-2000~~ 5-25-05
PARTY CHIEF: Wilcoxen
CREW:
TYPE OF MARKER: Harrison
METHOD OF ESTABLISHMENT: County: 8-27-2000

IN. S.P.C. E ZONE, NAD 83
NAME: 15041405
N: 499446.1477(m)
E: 66770.8754(m)

THIS CORNER POSITION REPRESENTS A "TITLE" CORNER AND MAY NOT NECESSARILY REPRESENT THE POSITION BASED ON RECORD CORNERS.

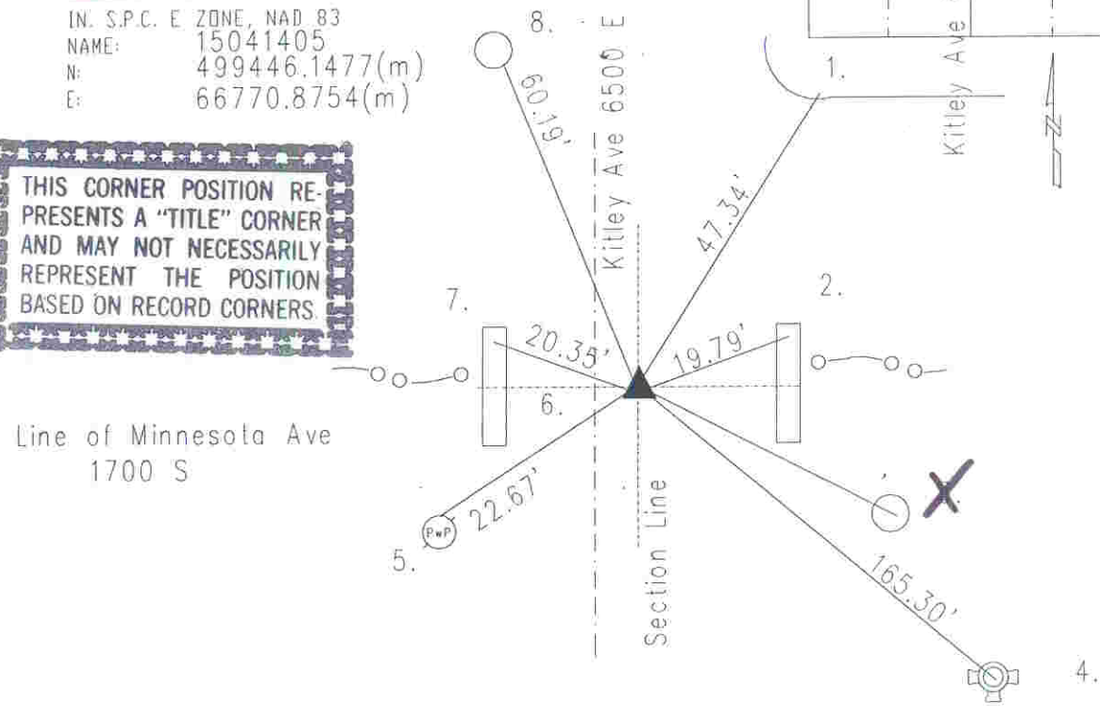

A survey by D.B. Hosbrook 2-28-1860 indicates no stone but following witnesses: 6" sugar N 43 W 13 1/2 links; 8" beech S 63 1/2 W 29 links per Warren Township Legal Survey Book pg. 21. H.W. Klausurman 5-8-03 indicates a found stone but no witnesses per Warren Township Legal Survey Book pg. 22. Scherschel 5-15-63 called a railroad spike. Wilcoxen 9-17-75 called an iron pin. Gries 12-6-88 called the same. Kiste 4-25-85 called an iron pin 2" dn. Wilcoxen 8-27-00 called an iron pin 2" down. Excavated by Wilcoxen 10-27-00 and a shaft of a copperweld was found 3" down. No stone nor other witnesses were found. Harrison set.

HC541405

REF.	DISTANCE	DESCRIPTION
1.	47.34'	NE corner of drive entrance for ADDRESS 1609
2.	19.79'	Cut 'x' N-end concrete headwall (over creek)
3.	~~31.08'~~	~~1" pipe property corner 36" tall~~
4.	165.30'	Top nut of fire hydrant
5.	22.67'	PK nail N PwP#85-616 36" up
6.	4'+/-	Due W to C/L
7.	20.35'	NW concrete headwall
8.	60.19'	Face of steel mailbox post for ADDRESS #1610