The OFFICE of the MARION COUNTY SURVEYOR

SECTION CORNER RECORD
MARION COUNTY, INDIANA

Sec. 14 Twp. 15 Range 4

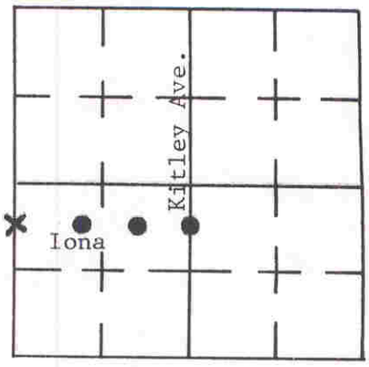

DATE: - -

CREW: P.C.-

INST. - ROD. -

TYPE of MARKER: COND. of MARKER:

METHOD of ESTABLISHMENT:

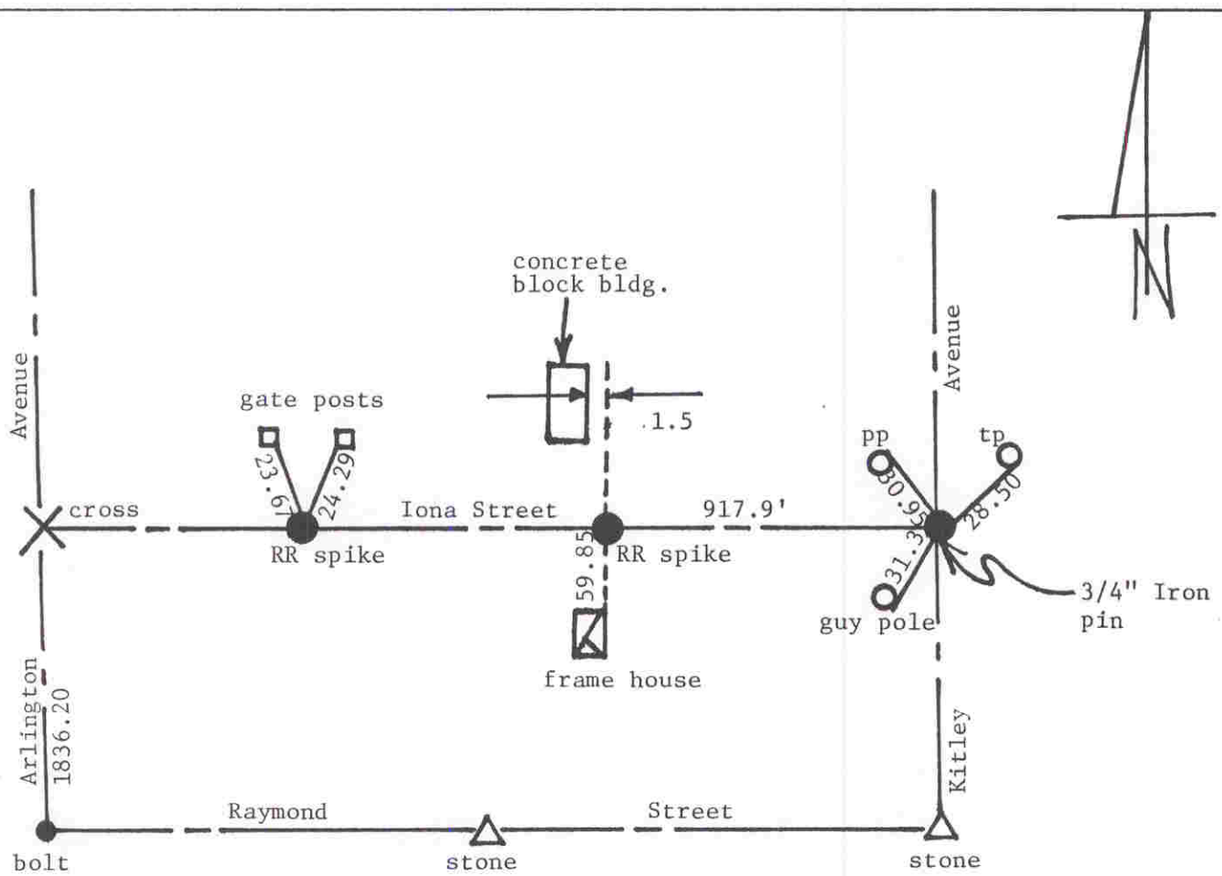

PX5414A

REFERENCE	DISTANCE	DESCRIPTION