c

OFFICE OF THE MARION COUNTY SURVEYOR
SECTION RECORD CORNER
SECTION 16 TOWNSHIP 15 RANGE 4
DATE: ~~1-17-95~~ 4-30-2000
PARTY CHIEF: Whiteside
CREW:
TYPE OF MARKER: PK
METHOD OF ESTABLISHMENT: County: 11-18-88

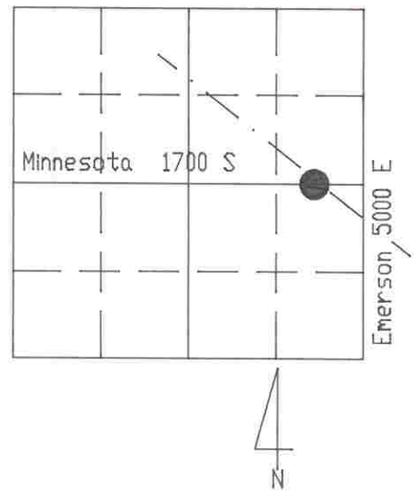

NOTE: This corner position represents a title corner and may not necessarily be in the position of the Record corner.

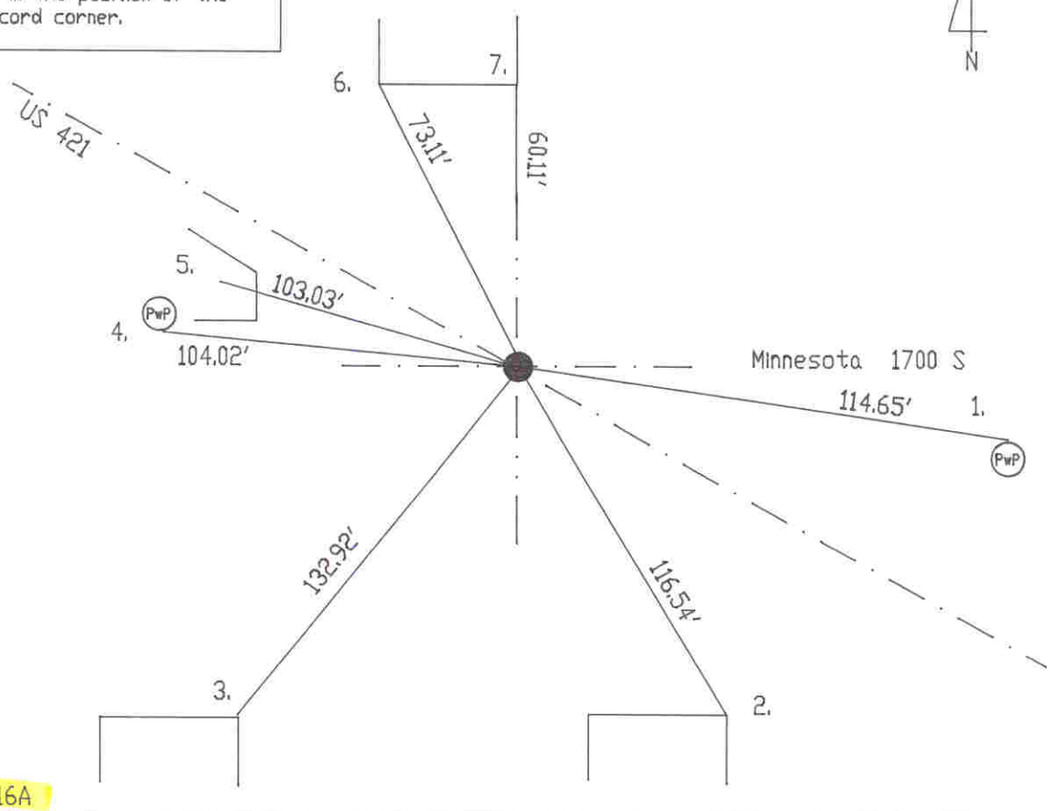

IX5416A

REF.	DISTANCE	DESCRIPTION
1.	114.65'	Rd N PwP#66-613A 12"up
2.	116.54'	NE #5007 24"up
3.	132.92'	NE #5025 24"up
4.	104.02'	Rd S PwP#24-573B 6"up
5.	103.03'	'x' hdwl
6.	73.11'	SW #5024 1/2
7.	60.11'	SE "