OFFICE OF THE MARION COUNTY SURVEYOR
SECTION RECORD CORNER
SECTION 22 TOWNSHIP 15 RANGE 4
DATE: ~~11-24-99~~ ~~3-21-2000~~ 4-6-05
PARTY CHIEF: ~~Wilcoxen~~ Kiste
CREW:
TYPE OF MARKER: Capped rebar Fd in grass median
METHOD OF ESTABLISHMENT: County: 10-20-88

NOTE: This corner position represents a title corner and may not necessarily be in the position of the Record corner.

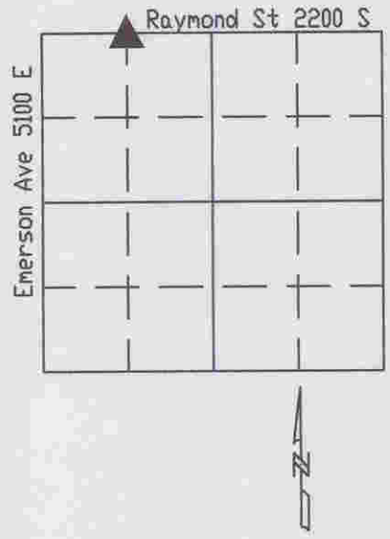

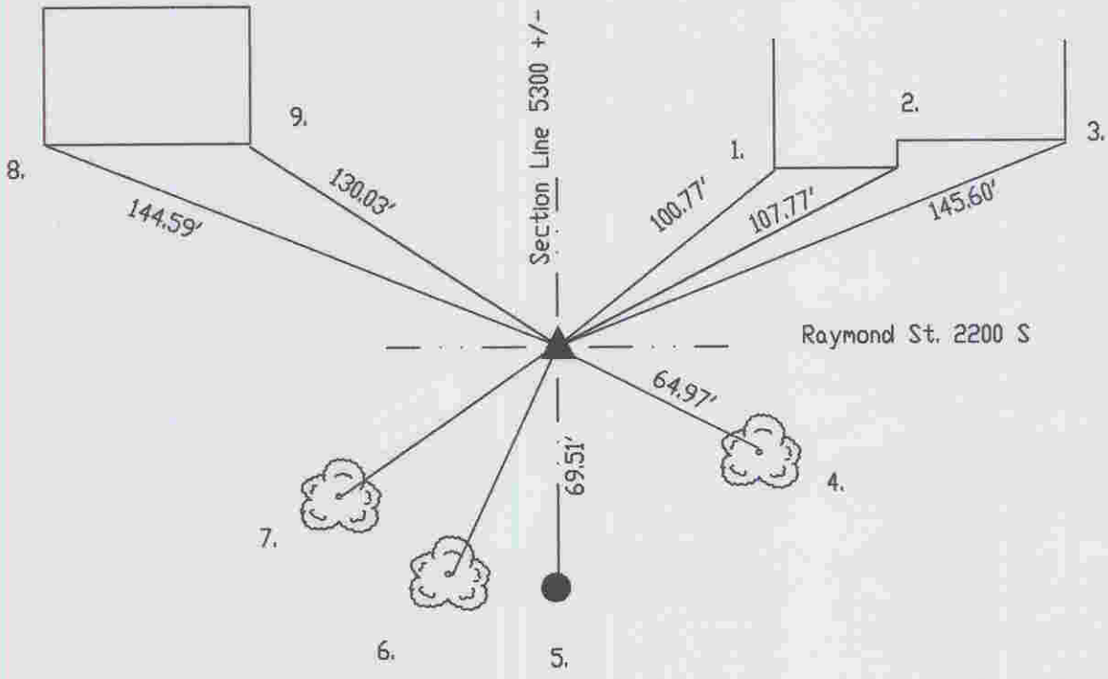

SX542210

REF.	DISTANCE	DESCRIPTION
1.	100.77'	SW corner of 1-story stone ADDRESS 5304
2.	107.77'	SE corner "
3.	145.60'	SE corner "
4.	64.97'	Mag nail E spur root 15" black locus
5.	69.51'	Due S to "capped rebar by Weihe"
6.	71.47'	Mag nail w/brass washer E 10" black locus 12"up
7.	73.60'	Mag nail w/brass washer E 6" locus stump: 12"up
8.	144.59'	SW corner of wood & brick ADDRESS 5300
9.	130.03'	SE corner "