OFFICE OF THE MARION COUNTY SURVEYOR
SECTION RECORD CORNER
SECTION 23 TOWNSHIP 15 RANGE 4
DATE: 7-19-03
PARTY CHIEF: Wilcoxen
CREW:
TYPE OF MARKER: Cut 'x' in bridge
METHOD OF ESTABLISHMENT: County: 12-14-98

NOTE: This corner position represents a title corner and may not necessarily be in the position of the Record corner.

IN.S.P.C. E ZONE, NAD '83
Name: 15042318
N: 497827.4620(m)
E: 67182.9880(m)

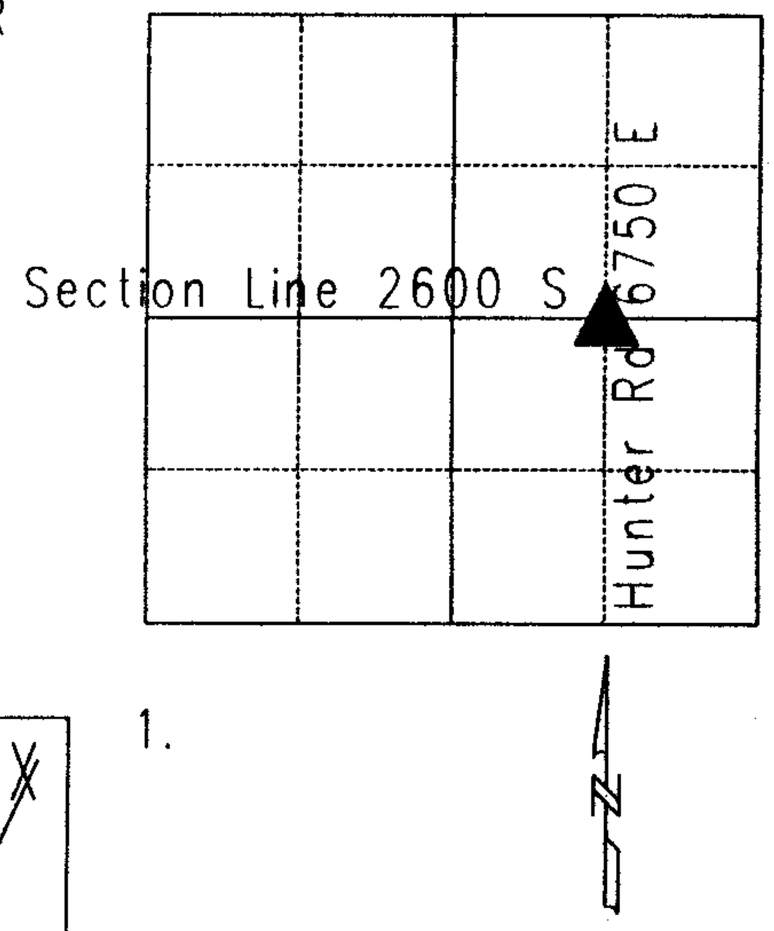

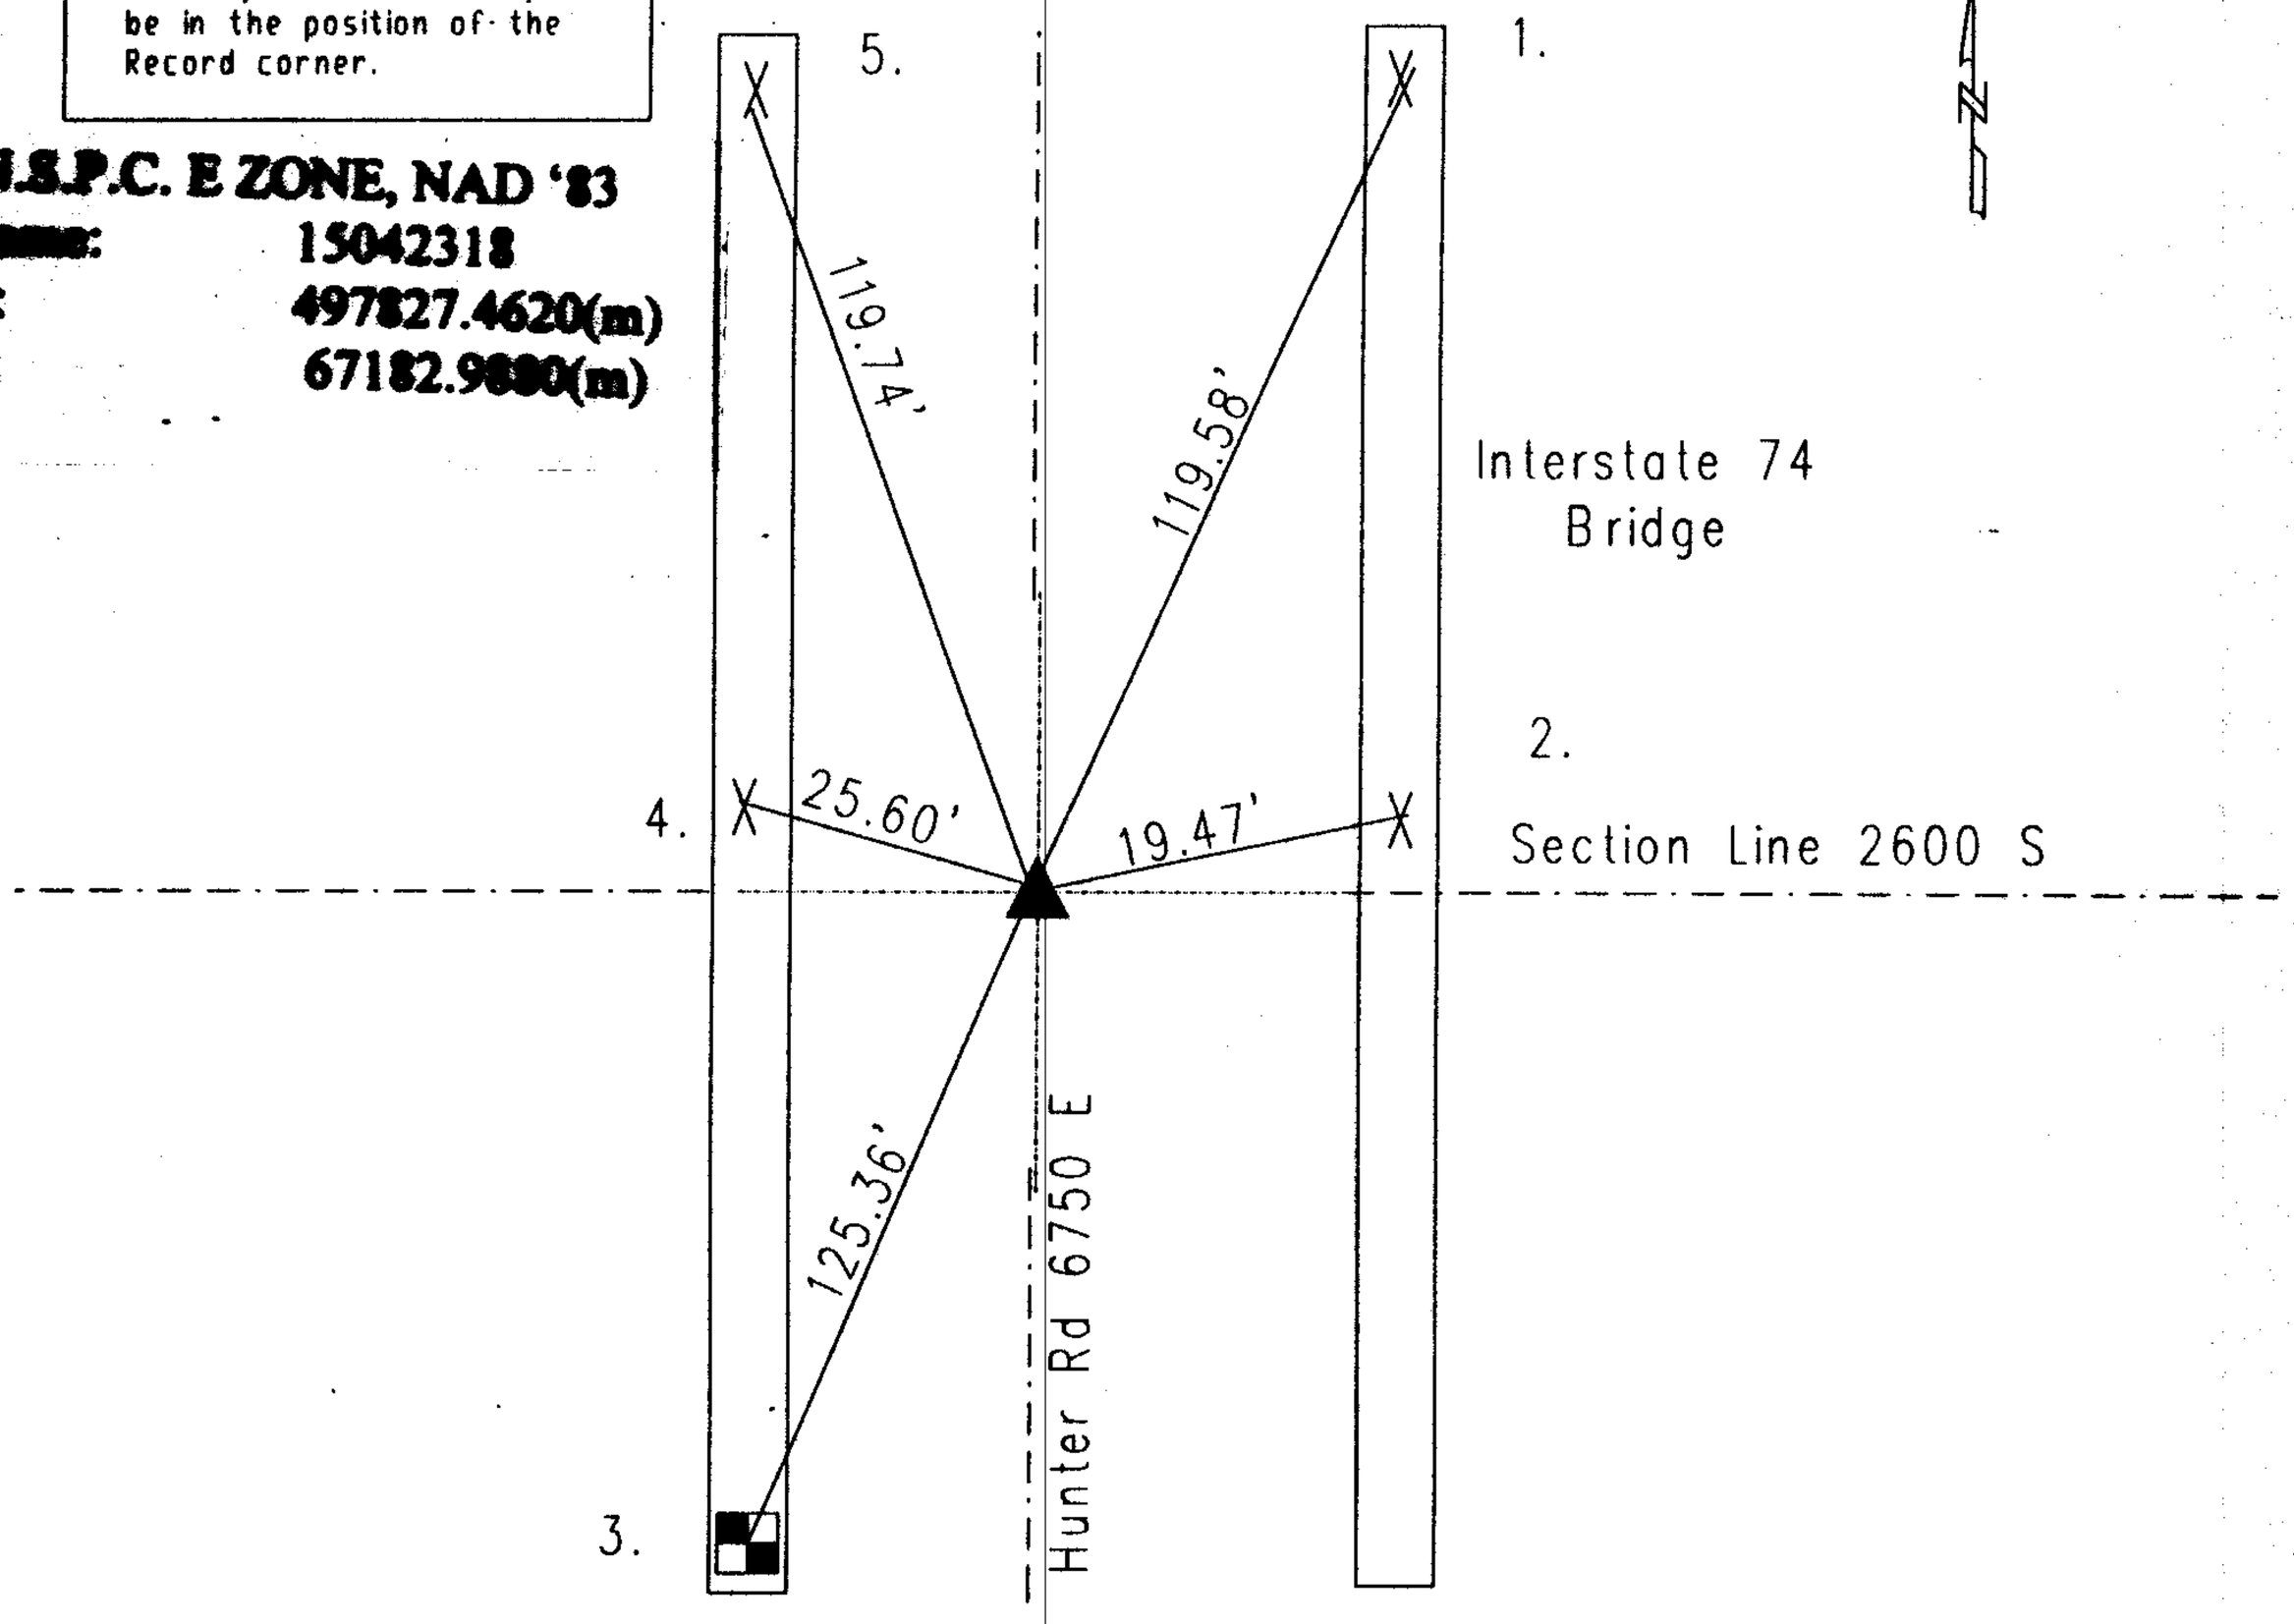

SX542318

REF.	DISTANCE	DESCRIPTION
1.	119.58'	Cut 'x' in concrete headwall
2.	19.47'	Cut 'x' in concrete headwall
3.	125.36'	Center of IDOT benchmark
4.	25.60'	Cut 'x' in concrete headwall
5.	119.74'	Cut 'x' in concrete headwall